



ADDENDUM NO. 1 - OUTLINE AND SUMMARY INFORMATION

Project Name: Renne Library Data Center Fire Protection System Upgrades PPA: 20-0036
Location: Montana State University – Bozeman Date: 01/28/2021
Owner: State of Montana, MSU - Bozeman
Plew Building 6th and Grant, PO Box 172760
Bozeman, Montana 59717-2760

To: *All Plan Holders of Record*

*The Plans and Specification prepared by **Coffman Engineers** dated **January 17, 2021** shall be clarified and added as follow. The bidder proposes to perform all the following clarifications or changes. It is understood that the Base Bid shall include any modification of Work or Additional Work that may be required by reason of the following change or clarifications.*

The Bidders are to acknowledge the receipt of this Addendum by inserting its number and date into their Bid Forms. Failure to acknowledge may subject the Bidder to disqualification and rejection of the bid. This Addendum forms part of the Contract Documents as if bound therein and modifies them as follows:

1. AMENDMENTS TO THE PROJECT MANUAL

a. N/A

2. AMENDMENTS TO THE DRAWINGS

a. Sheet FA0.1, FA1.0 & FX0.2

3. PRE-BID MEETING INFORMATION

a. A pre-bid meeting was conducted on 1/26/21. All attendees (see attached list) were given a brief overview of the contract requirements as well as the project scope. A walk through of the spaces affected by the project scope was conducted. It was pointed out that this is an operational data center, and all equipment needs to remain protected and operational during construction. The contractor is responsible for providing means and method for protection of the equipment work while still allowing for the cooling system to operate correctly. See section 5 below for clarification to questions asked during the pre-bid meeting.

4. PRIOR APPROVALS

a. N/A

5. OTHER

a. As indicated in the specifications, flexible pipe drops (off the top of the branch line) to the pendent sprinklers in the suspended acoustical tile are acceptable in lieu of hard piped return bends shown on the drawings. Contractor would need to submit on proposed flexible pipe drops for approval per the specifications.

- b. As required by NFPA 13 to not cause damage during testing, the main drain from the new pre-action system riser shall be piped to the exterior through the West wall of the mechanical room (approximately 1' above grade). An auxiliary drain is to be installed on the main drain for system drainage to the existing floor sink below the riser.
- c. It has been clarified that the existing Halon system and associated detection and releasing system shall be left in place and operational until the new pre-action system and detection system for releasing are active. Once the new pre-action system is operational, the existing Halon system and associated detection and releasing system can be removed. Release of the Halon system may be disarmed during construction periods where people are working in the space, but the detection system shall remain active. The halon system shall be put back in service at the end of each work period.
- d. As indicated in the revised drawings noted in Section 2 above, the detection for the pre-action system release has been changed from heat detection to smoke detection. Relays have also been added for shutdown of the cooling units in the data center upon activation of the area smoke detection.
- e. Seismic Details have been updated on drawing FX0.2 to reflect a change from the Hilit TZ Wedge Anchor to the Dewalt Power Stud Wedge Anchor to match Seismic Calculations. Contractor may submit other similar anchors for approval as indicated in the specifications.

6. ATTACHMENTS

- a. Pre-bid meeting attendance list

b. Revised Sheets FA0.1, FA1.0, FX0.2

RENNE
Data Center Fire Upgrades

1/26/21

Pre Bid Mtg Attendance

Name	Company	Phone	Email
DAVE YAGGY	W.S.F.P	406 539 5121	DAVE.YAGGY@WSFP
Jason Anderson	Coffman Eng	406-582-1936	anderson@coffman.com
Michael Bergman	PRG Commercial	406-829-4795	mbergman@prgcommercialMT.com
Jason Boyer	PRG Commercial	406-920-1146	j.boyer@prgcommercialmt.co
John Case	ITM division	406 465 8129	johnboy95@gmail.com
RBERNDT	ICI	406 579 8550	rd@in-tch.com
Sam Taylor	MSU-VIT	406 570-0798 cell 406 994-6511 office	Samuel.taylor1@montana.edu
TODD COOK	MSU	406-580-7900	TODD.COOK@MONTANA.EDU
Tony Colliard	MSU	406-580-0666	Acolliard@MONTANA.EDU

Loras O'Toole	MSU	406-548-4930	loras@montana.edu
---------------	-----	--------------	-------------------

FIRE ALARM NOTES:

- FIRE ALARM SYSTEM SHALL COMPLY WITH:
 - A. NFPA 13 (FIRE SPRINKLER CODE), 2016
 - B. NFPA 70 (NATIONAL ELECTRIC CODE), 2018
 - C. NFPA 72 (FIRE ALARM CODE), 2016
 - D. IBC (INTERNATIONAL BUILDING CODE), 2018
 - E. IFC (INTERNATIONAL FIRE CODE), 2018
 - F. IMC (INTERNATIONAL MECHANICAL CODE), 2018
 - G. ADA/ABA, 2004
 - H. PROJECT SPECIFICATIONS
 - I. LOCAL AND STATE AHJ REQUIREMENTS
- THESE DRAWINGS REPRESENT ENGINEERED FINALIZED SHOP DRAWINGS READY FOR INSTALLATION. THE CONTRACTOR SHALL PROVIDE RED-LINE FIELD ASBUILTS TO THE FIRE PROTECTION ENGINEER. THE FIRE PROTECTION ENGINEER WILL PREPARE AND PROVIDE RECORD DRAWINGS. THE CONTRACTOR IS RESPONSIBLE FOR COMPLETED NFPA 72 INSPECTION & TESTING, RECORD OF COMPLETION FORMS AND AND PROVIDE OPERATION & MAINTENANCE MANUALS TO THE OWNER REPRESENTATIVE.
- COORDINATE THE EXACT DEVICE LOCATIONS WITH ELECTRICAL AND MECHANICAL SYSTEM EQUIPMENT AND BUILDING ARCHITECTURAL FEATURES. INSTALLING CONTRACTOR SHALL CONSULT/CONFIRM ANY NECESSARY DEVIATION OF DEVICE BOX PLACEMENT OR CONDUIT/CIRCUIT ROUTING WITH THE DESIGNER OF RECORD PRIOR TO IMPLEMENTING CHANGES IN THE FIELD.
- CONDUIT SHALL BE USED AT ALL LOCATIONS. FIRE ALARM CONDUIT SHALL BE FACTORY RED 3/4" MINIMUM UNLESS OTHERWISE NOTED. CONCEAL CONDUITS IN WALL AND CEILING SPACES WHEREVER FEASIBLE. SURFACE CONDUIT IN FINISHED AREAS SHALL BE 3/4" MINIMUM UNLESS OTHERWISE NOTED AND PAINTED TO MATCH SURROUNDINGS.
- MINIMUM CIRCUIT PERFORMANCE REQUIREMENTS:
 - IDC - INITIATING DEVICE CIRCUIT SHALL BE CLASS B.
 - NAC - NOTIFICATION APPLIANCE CIRCUIT SHALL BE CLASS B.
 - SLC - SIGNALING LINE CIRCUIT SHALL BE CLASS B. KEEP T-TAPS TO A MINIMUM.
- "T" TAPPING OF ANY NAC OR IDC CIRCUIT IS PROHIBITED.
- ALL NOTIFICATION APPLIANCES SHALL OPERATE IN SYNCHRONIZATION AS REQUIRED BY NFPA 72.
- PAIN FIRE ALARM JUNCTION BOXES AND COVERS RED. BOTH SIDES OF COVER PLATES SHALL BE PAINTED RED. ALL CONDUIT/RACEWAY SHALL BE PAINTED RED.
- FIRE ALARM EQUIPMENT CABINETS, BOXES, AND DEVICES SHALL HAVE TAGS PERMANENTLY AFFIXED TO THE FACE. LABEL EACH DEVICE USING SELF-ADHESIVE LASER PRINTED COMMERCIALY AVAILABLE ID TAGS. ADDRESSABLE DEVICES SHALL BE LABELED WITH ADDRESS. NOTIFICATION APPLIANCES SHALL BE LABELED WITH THEIR ASSOCIATED NAC IDENTIFIER MATCHING THAT ON THESE PLANS. LABEL ALL MONITOR AND RELAY MODULES WITH ASSOCIATED FUNCTION. LABEL REMOTE TEST SWITCHES WITH ASSOCIATED DUCT DETECTOR ADDRESS AND AIR HANDLER DESIGNATION.
- DO NOT SPLICE FIRE ALARM CONDUCTORS EXCEPT WHERE INDICATED ON THESE DRAWINGS. ALL FIRE ALARM WIRING SHALL ONLY BE TERMINATED AT A DEVICE OR APPROVED TERMINAL BLOCK LOCATION ONLY.

ELECTRICAL NOTES:


- THE CONTRACTOR SHALL COMPLY WITH THE CONSTRUCTION PRACTICES AND REQUIREMENTS OF THE REFERENCED EDITION OF THE NATIONAL ELECTRIC CODE (2011 NFPA 70), CURRENT NATIONAL ELECTRICAL SAFETY CODE, AND INSTRUCTIONS OF MANUFACTURERS OF EQUIPMENT AND MATERIALS SUPPLIED FOR THE PROJECT.
- THE CONTRACTOR SHALL PROVIDE AND INSTALL ALL JUNCTION AND PULL BOXES REQUIRED FOR THE INSTALLATION OF ELECTRICAL DEVICES AND EQUIPMENT. WHETHER OR NOT SPECIFICALLY INDICATED ON THE PLANS, SIZING OF THESE BOXES SHALL BE PER THE NATIONAL ELECTRICAL CODE.
- ALL PENETRATIONS THROUGH FIRE BARRIERS SHALL BE FIRE STOPPED TO MAINTAIN THE INTEGRITY OF THE FIRE BARRIER. FIRE STOPPING MATERIAL SHALL BE U.L. LISTED.
- THE CONTRACTOR SHALL OBTAIN APPROVAL FROM THE GENERAL CONTRACTOR QUALITY CONTROL REPRESENTATIVE PRIOR TO MAKING ANY PENETRATIONS THROUGH STRUCTURAL MEMBERS.
- SHOULD PROJECT CONDITIONS REQUIRE REARRANGEMENT OF WORK, THE CONTRACTOR SHALL MARK SUCH CHANGES ON THE AS-BUILT DRAWINGS. IF THESE CHANGES REQUIRE ALTERNATE METHODS TO THOSE SPECIFIED IN THE CONTRACT DOCUMENTS, THE CONTRACTOR SHALL SUBMIT DRAWINGS SHOWING THE PROPOSED ALTERNATE METHODS TO THE GENERAL CONTRACTOR. THE CONTRACTOR SHALL NOT PROCEED UNTIL APPROVAL IS OBTAINED. REARRANGEMENT OF WORK FOR THE PURPOSE OF COORDINATION SHALL NOT BE CONSIDERED AN ITEM FOR EXTRA COST.
- REPAIR ANY DAMAGE TO EXISTING CONSTRUCTION RESULTING FROM THE INSTALLATION OF ELECTRICAL ITEMS. THE AREAS REPAIRED SHALL MATCH THE ADJACENT SURFACES IN TEXTURE AND COLOR.
- ALL EXPOSED AND CONCEALED CONDUITS SHALL BE EMT (ELECTRICAL METALLIC TUBING). ALL UNDERGROUND CONDUIT SHALL BE PVC CONDUIT SCHEDULE 40, UNLESS NOTED OTHERWISE. USE FLEXIBLE METAL CONDUIT AND SEAL-TIGHT WHERE APPLICABLE.
- ALL EQUIPMENT SHALL BE CAPABLE OF FITTING IN THE SPACES LOCATED WHILE MEETING THE MANUFACTURER'S RECOMMENDED ACCESS REQUIREMENTS. REVIEW ALL PLACES WHERE EQUIPMENT IS TO BE INSTALLED PRIOR TO ORDERING OF EQUIPMENT AND NOTIFY THE CONTRACTING OFFICER OF ANY INADEQUATE CLEARANCES OR CONDITIONS THAT WILL PREVENT THE PROPER INSTALLATION, MAINTENANCE, AND OPERATIONS OF THE EQUIPMENT.
- PROVIDE ACCESS PANELS TO ALL CONCEALED TRANSFORMERS, DEVICES, JUNCTION BOXES AND EQUIPMENT. COORDINATE THE LOCATION OF ACCESS PANELS TO INSURE THAT THE EQUIPMENT CAN BE MAINTAINED ADEQUATELY.
- ALL EQUIPMENT AND CABLE SHALL BE PROPERLY RATED FOR THE CONDITIONS IN WHICH IT IS INSTALLED.
- ALL 120VAC CIRCUIT BREAKERS SERVING FIRE ALARM EQUIPMENT SHALL BE RED AND LOCKABLE.
- ANY PENETRATION OF THE BUILDING VAPOR BARRIER SYSTEM SHALL BE APPROPRIATELY SEALED TO RETAIN THE INTEGRITY OF THE SYSTEM. THIS INCLUDES BUT IS NOT LIMITED TO CONDUITS AND BACKS OF ELECTRICAL BOXES.

WIRE & CABLE LEGEND

TAG	TYPE	CIRCUIT DESCRIPTION
B	16-2 UTP-FPL	SIGNALING LINE CIRCUIT
N	2 #14 THHN	NOTIFICATION APPLIANCE CIRCUIT - STROBES
P	2 #14 THHN	AUXILIARY 24VDC RISER
Y	2 #14 THHN	INITIATING DEVICE CIRCUIT 'CLASS B'
Z	3 #12 THHN	120VAC POWER CIRCUIT

INSTALLING CONTRACTOR SHALL PROVIDE COLOR CODED CABLING FOR DIFFERENT CIRCUIT TYPES. MAINTAIN COLOR CODE THROUGHOUT EACH CIRCUIT.

NOTIFICATION APPLIANCE DEVICE ANNOTATION

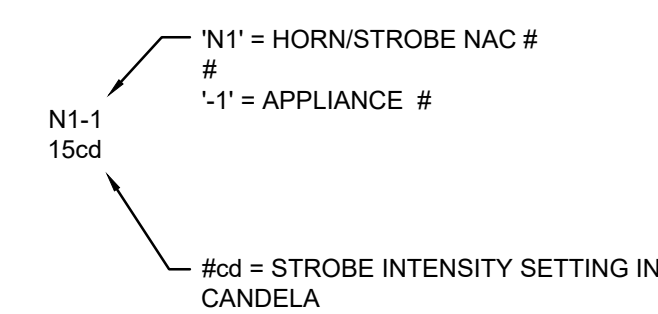

SCOPE OF WORK

- THE EXISTING EST-3X SYSTEM WILL REMAIN IN PLACE
- A NEW CIRCUIT WITH NEW HORN/STROBES WILL BE INSTALLED FROM THE EXISTING FIRE PANEL.
 - HEAT DETECTORS REQUIRED FOR A PREACTION FIRE SPRINKLER SYSTEM WILL BE INSTALLED FROM THE EXISTING SLC CIRCUIT


ACRONYMS/ABBREVIATIONS:

- AFF ABOVE FINISHED FLOOR
- AC ALTERNATING CURRENT
- AWG AMERICAN WIRE GAGE
- BFC BELOW FINISHED CEILING
- CD CANDELA
- CKT CIRCUIT BREAKER
- C CONDUIT
- DB DECIBEL
- DED DEDICATED
- DC DIRECT CURRENT
- EMT ELECTRICAL METALLIC TUBING
- EOL END OF LINE RESISTOR
- EOLR END OF LINE RELAY
- ETR EXISTING TO REMAIN
- XP EXPLOSION PROOF
- FA FIRE ALARM
- FPL FIRE ALARM POWER LIMITED
- HVAC HEATING VENTILATING AIR CONDITIONING
- HZ HERTZ
- IAW IN ACCORDANCE WITH
- IDC INITIATING DEVICE CIRCUIT
- LV LOW VOLTAGE
- NAC NOTIFICATION APPLIANCE CIRCUIT
- NEMA NATIONAL ELECTRICAL MANUFACTURER ASSOC.
- NEC NATIONAL ELECTRIC CODE
- NIC NOT IN CONTRACT
- NTS NOT TO SCALE
- RGS RIGID GALVANIZED STEEL CONDUIT
- SLC SIGNALING LINE CIRCUIT
- SPDT SINGLE THROW DOUBLE THROW
- SPST SINGLE THROW SINGLE THROW
- TSP TWISTED SHIELDED PAIR
- UTP UNSHIELDED TWISTED PAIR
- UL UNDERWRITERS LABORATORIES
- V VOLT
- WP WEATHERPROOF
- W/ WITH
- WO WITHOUT

FIRE ALARM DEVICE LEGEND


SYMBOL	QTY	DESCRIPTION	MODEL	ROUGH-IN
[Symbol]	x	FIRE ALARM MASS NOTIFICATION CONTROL PANEL	EST3 X	FACP IS EXISTING
[Symbol]	1	PREACTION RELEASING PANEL	SIGA-REL	REQUIRES 24V FROM THE EXISTING PANEL. TO BE LOCATED WITHIN EXISTING PANEL. LOCATE NEXT TO EXISTING RELEASING MODULE
[Symbol]	16	ADDRESSABLE SMOKE DETECTOR W/STANDARD BASE	SIGA-PD W/SIGA-SB	REQUIRES 4" OCTAGON BOX OR 4" SQUARE WITH 3" ROUND RING.
[Symbol]	4	ADDRESSABLE MONITOR MODULE	SIGA-CT1 *	REQUIRES 4" SQUARE DEEP BOX WITH SINGLE GANG RING. ALL (4) MONITOR MODULES ARE EXISTING AND TO BE RE-USED
[Symbol]	N/A	PRESSURE SWITCH	BY OTHERS	FLEX TO ASSOCIATED MODULE
[Symbol]	N/A	LOW AIR ALARM	BY OTHERS	FLEX TO ASSOCIATED MODULE
[Symbol]	N/A	VALVE TAMPER SWITCH	BY OTHERS	FLEX TO ASSOCIATED MODULE
[Symbol]	N/A	WATERFLOW SWITCH	BY OTHERS	FLEX TO ASSOCIATED MODULE
[Symbol]	4	HORN STROBE - WALL - CLEAR LENS, RED BODY, MARKED 'FIRE'	GENESIS G4AVRF	REQUIRES 4 SQUARE DEEP BOX. MOUNT APPLIANCE UP 80"-96" BUT NOT LESS THAN 6" FROM FINISHED CEILING.
[Symbol]	1	STROBE - WALL - CLEAR LENS, RED BODY, MARKED 'FIRE'	GENESIS G4ARF	REQUIRES 4 SQUARE DEEP BOX. MOUNT APPLIANCE UP 80"-96" BUT NOT LESS THAN 6" FROM FINISHED CEILING.
[Symbol]	VARIES AS NEEDED	JUNCTION BOX		* SEE WIRING DIAGRAM FOR SPECIFIC MODEL OF MODULE BEING USED.
[Symbol]	1	SOLENOID	BY OTHERS	FLEX TO ASSOCIATED MODULE
[Symbol]	2	ADDRESSABLE RELAY MODULE	SIGA-CR	REQUIRES 4" SQUARE DEEP BOX WITH SINGLE GANG RING. ALL (4) MONITOR MODULES ARE EXISTING AND TO BE RE-USED

FIRE ALARM SYSTEM INPUTS	ANNUNCIATION	NOTIFICATION	CONTROL	OFF-SITE TRANSMITTED SIGNALS			
				D.1	D.2	D.3	D.4
INITIATING DEVICES							
MANUAL PULL STATION (EXISTING)	1.1	X	X			X	
DATA CENTER SMOKE DETECTOR	1.2	X	X		X		
DUCT DETECTOR (EXISTING)	1.3	X	X				X
RELAY MODULES						X	
FIRE SPRINK							
WATERFLOW / PRESSURE SWITCH	2.1	X	X		X		X
TAMPER SWITCH	2.2	X	X				X
PRE-ACTION LOW AIR	2.3	X	X				X
CONCURRENT SMOKE DET (1.2)	2.3					X	
CONTROL EQUIP							
LOW BATTERY VOLTAGE (EXISTING)	3.1	X	X				X
GROUND FAULT / OPEN / SHORT CIRCUIT (EXISTING)	3.2	X	X				X
AC POWER LOSS (EXISTING)	3.3	X	X				X

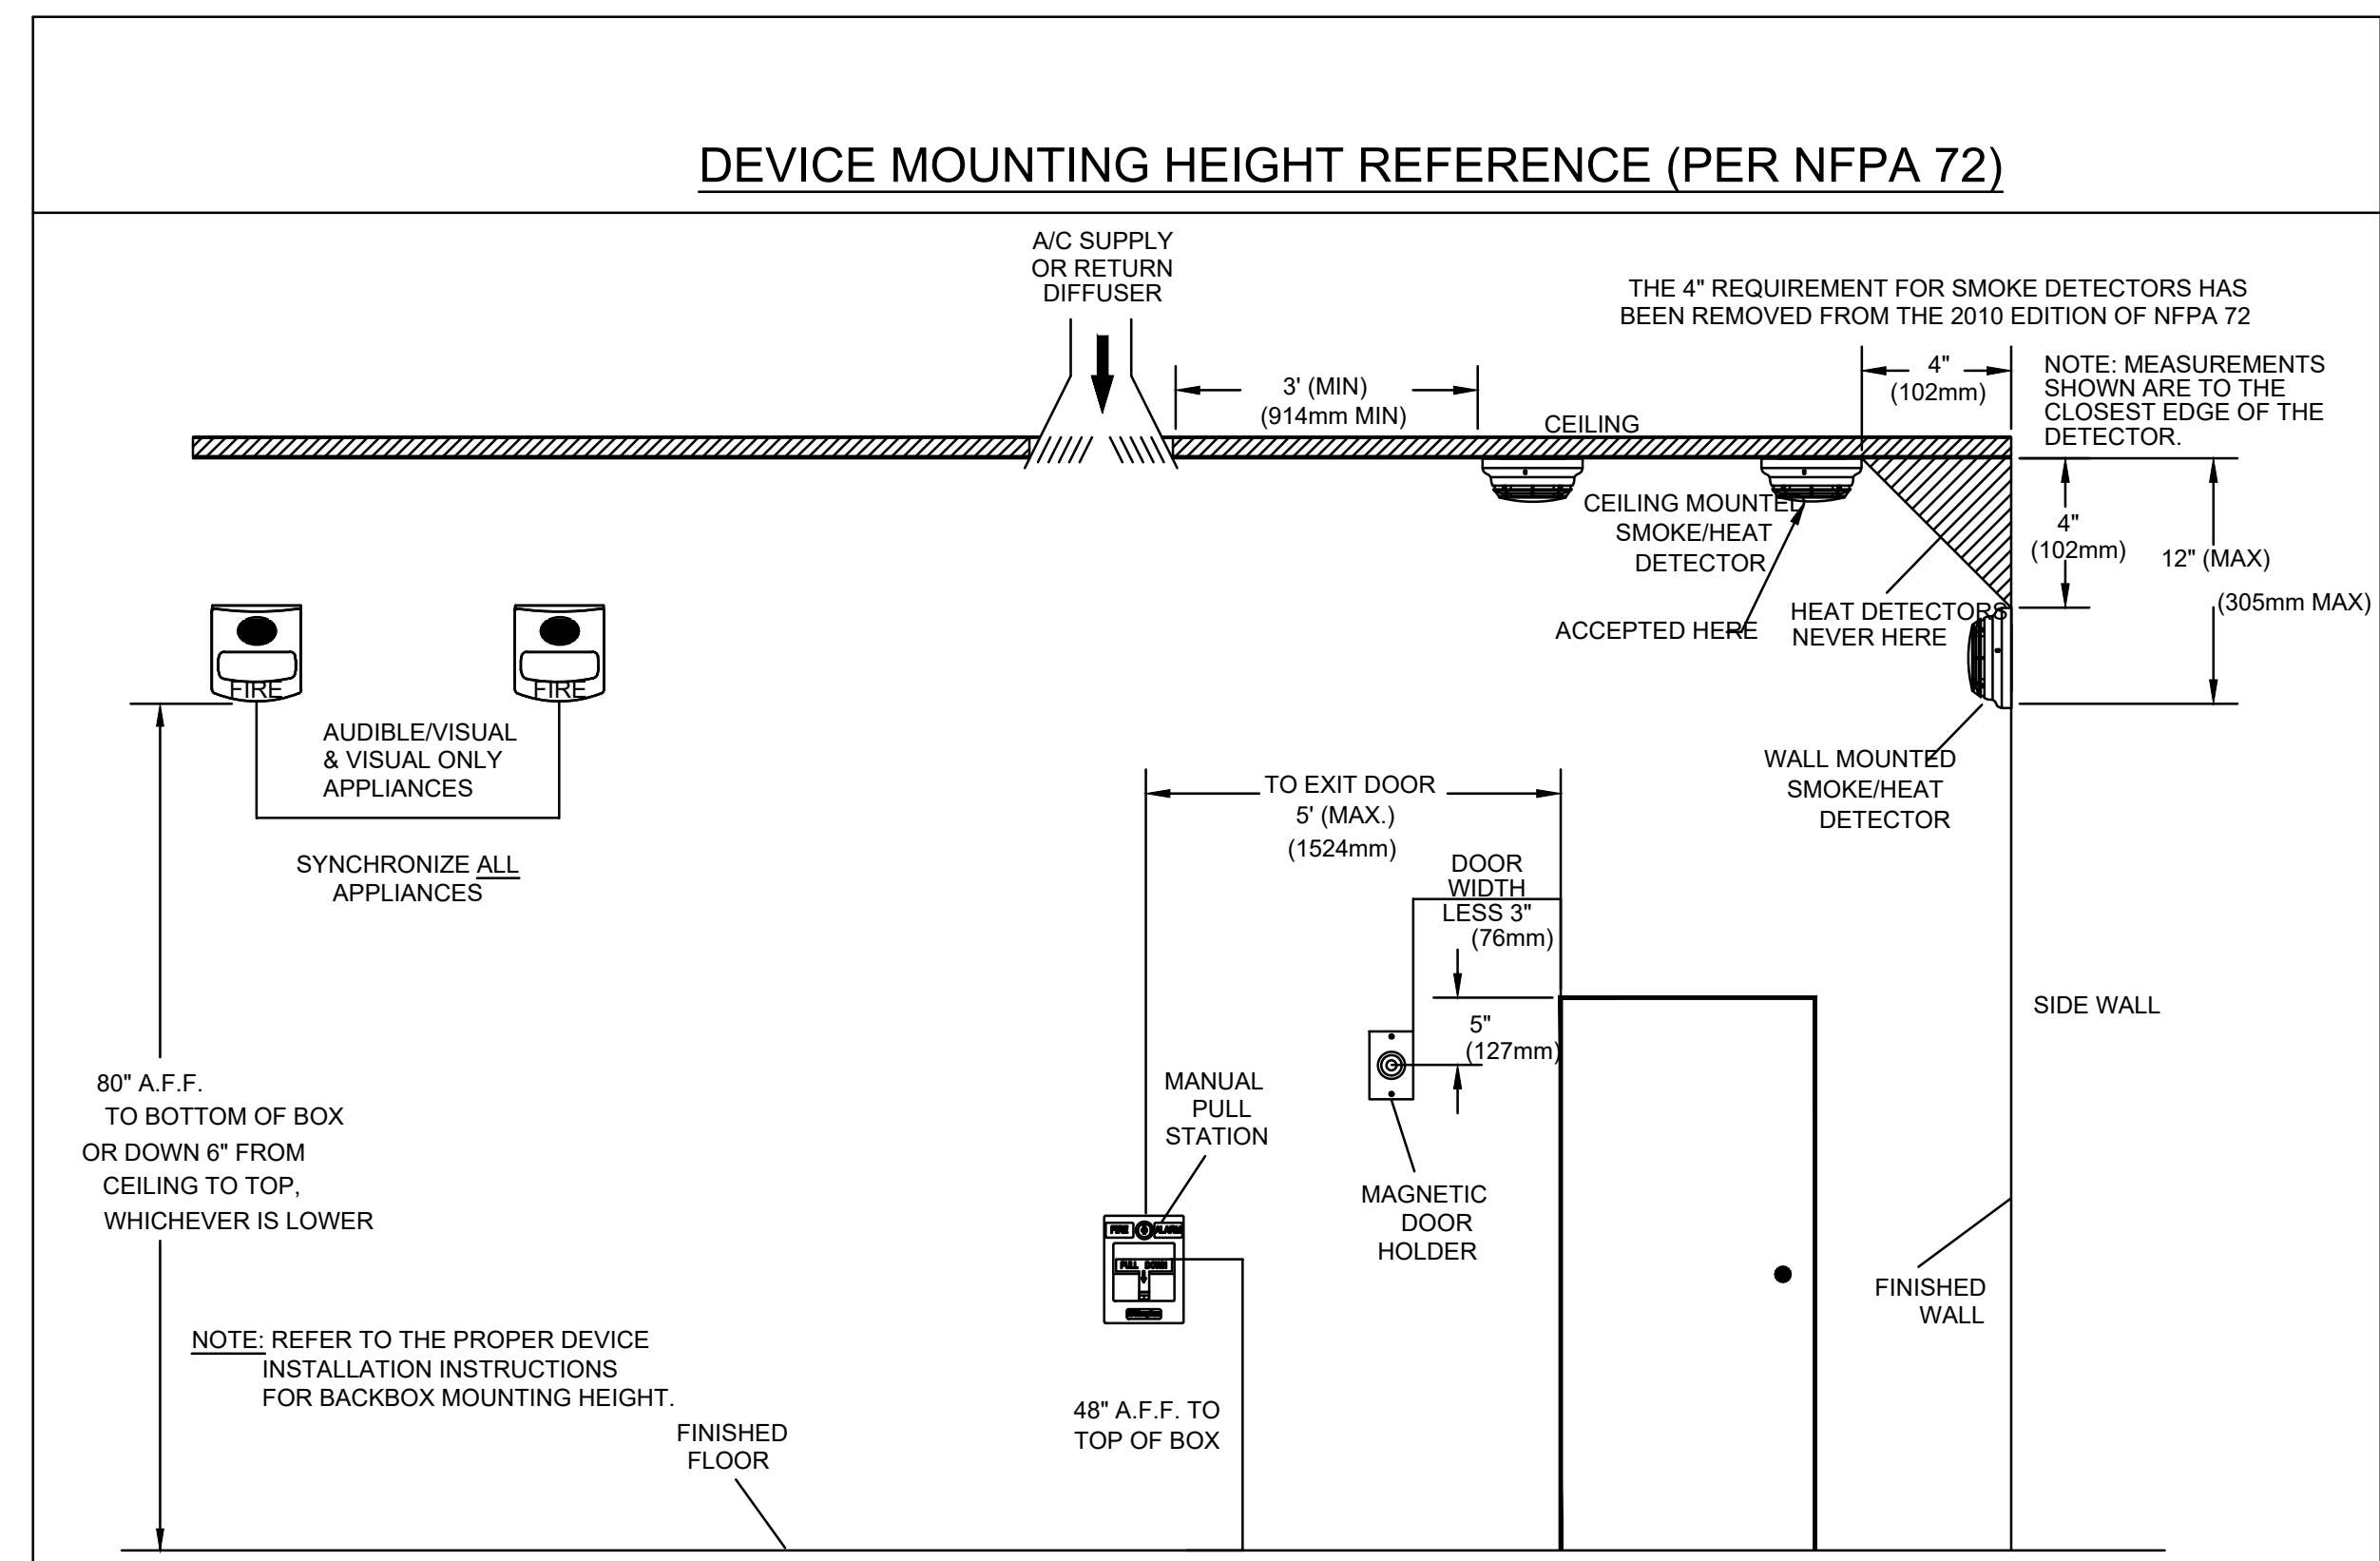

RISER DIAGRAM KEY NOTES


1. TIE NEW CIRCUIT INTO AN EXISTING NAC OUTPUT DEVICE TO BE REMOVED AND CIRCUIT TIED THROUGH. SHOWN ON RISER DIAGRAM FOR REFERENCE ONLY. RE-ADDRESS DEVICE AS SHOWN.

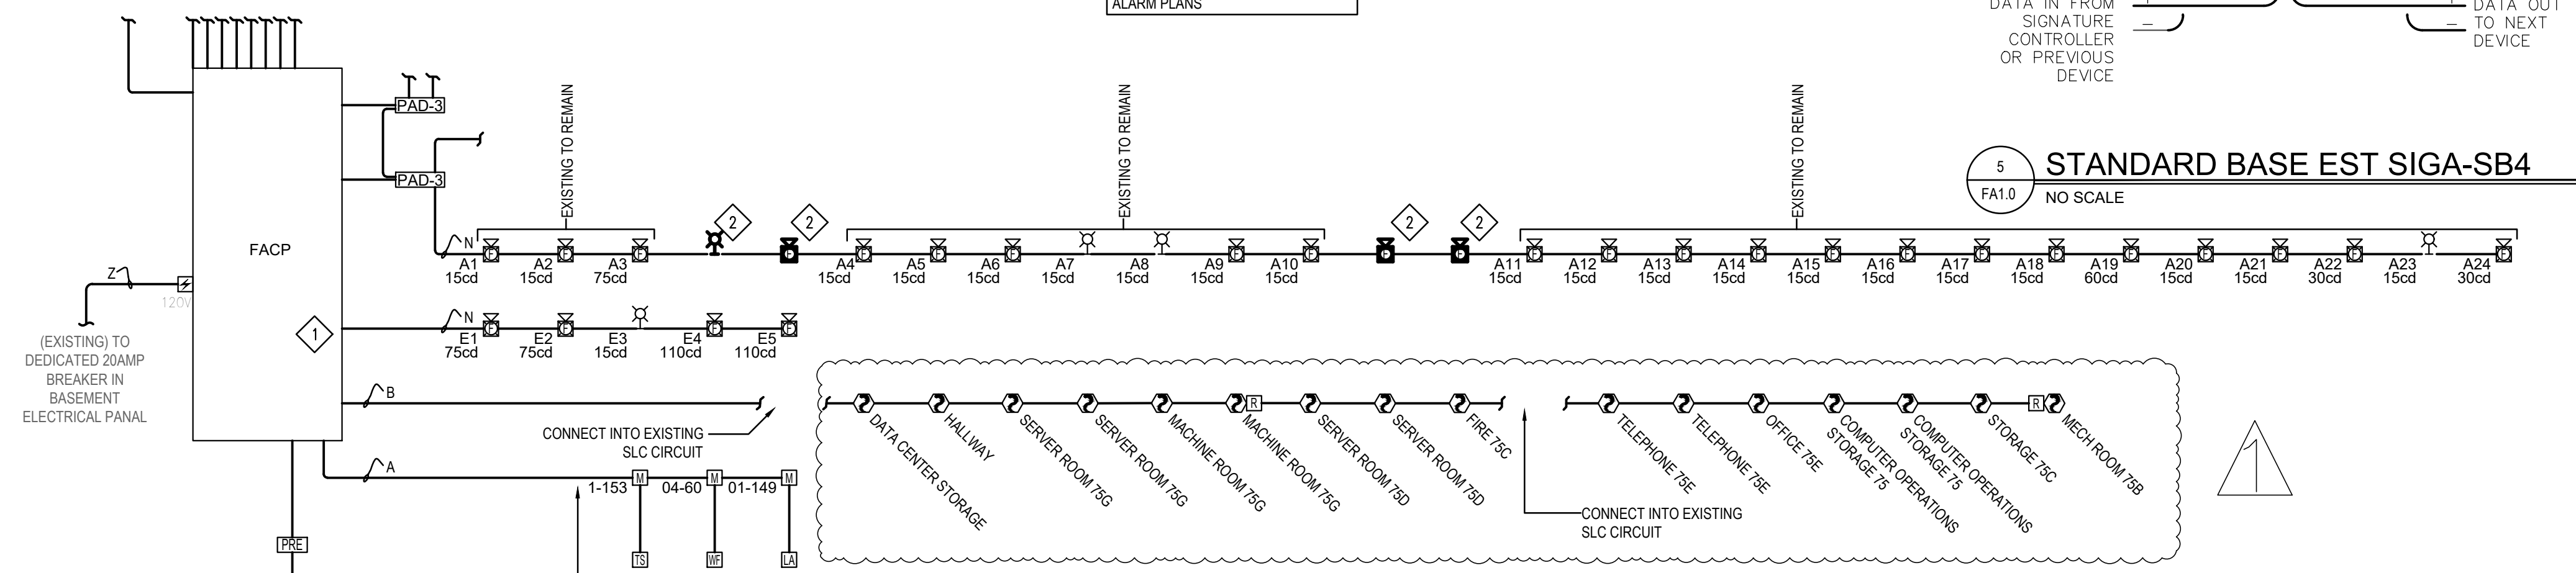


4 RISER DIAGRAM
FA1.0 NO SCALE

6 CIRCUIT 'E' LOAD/LOSS CALCULATION
FA1.0 NO SCALE


Device Number	Device Current	Distance from previous device	At Device	Voltage Drop	Percent Drop
Device 1	0.050	30	20.36	0.042	0.21%
Device 2	0.050	40	20.31	0.038	0.19%
Device 3	0.028	55	20.27	0.129	0.63%
Device 4	0.050	75	20.23	0.175	0.88%
Device 5	0.050	50	20.21	0.190	0.95%
END		20.21	0.190	0.95%	
END		20.21	0.190	0.95%	
Totals	0.228	250	End of Line Voltage	20.21	

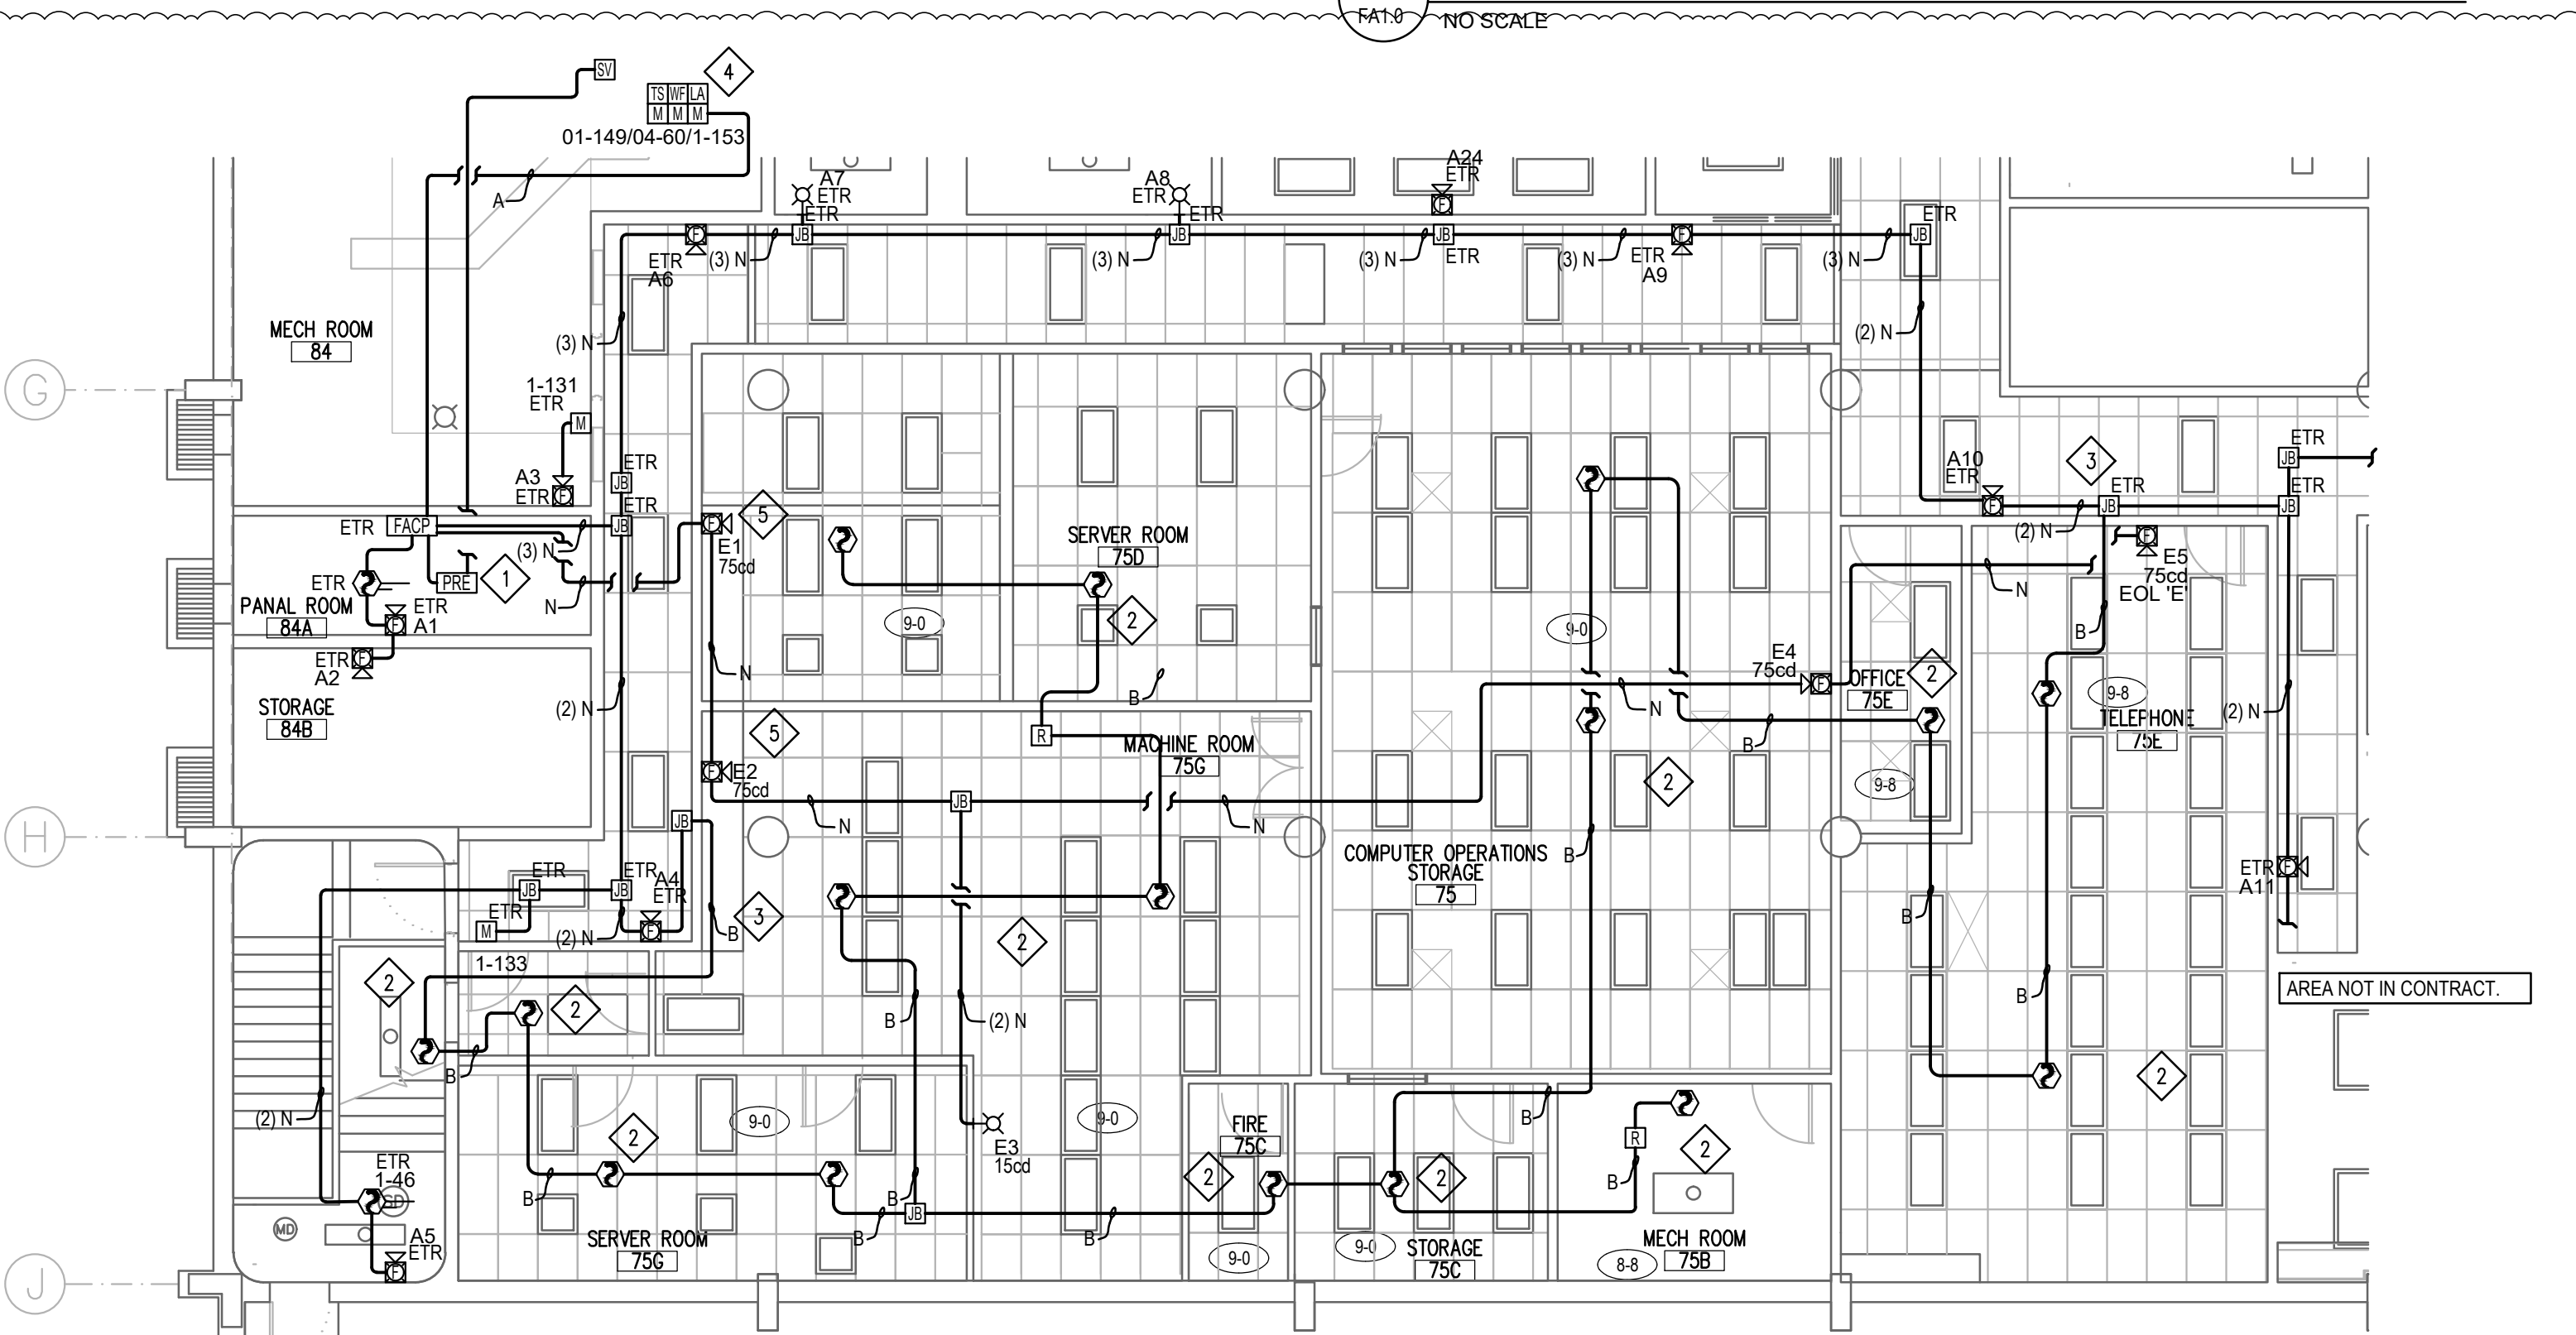


1 BASEMENT FLOOR - FIRE ALARM PLAN
FA1.0 1/8" = 1'-0"

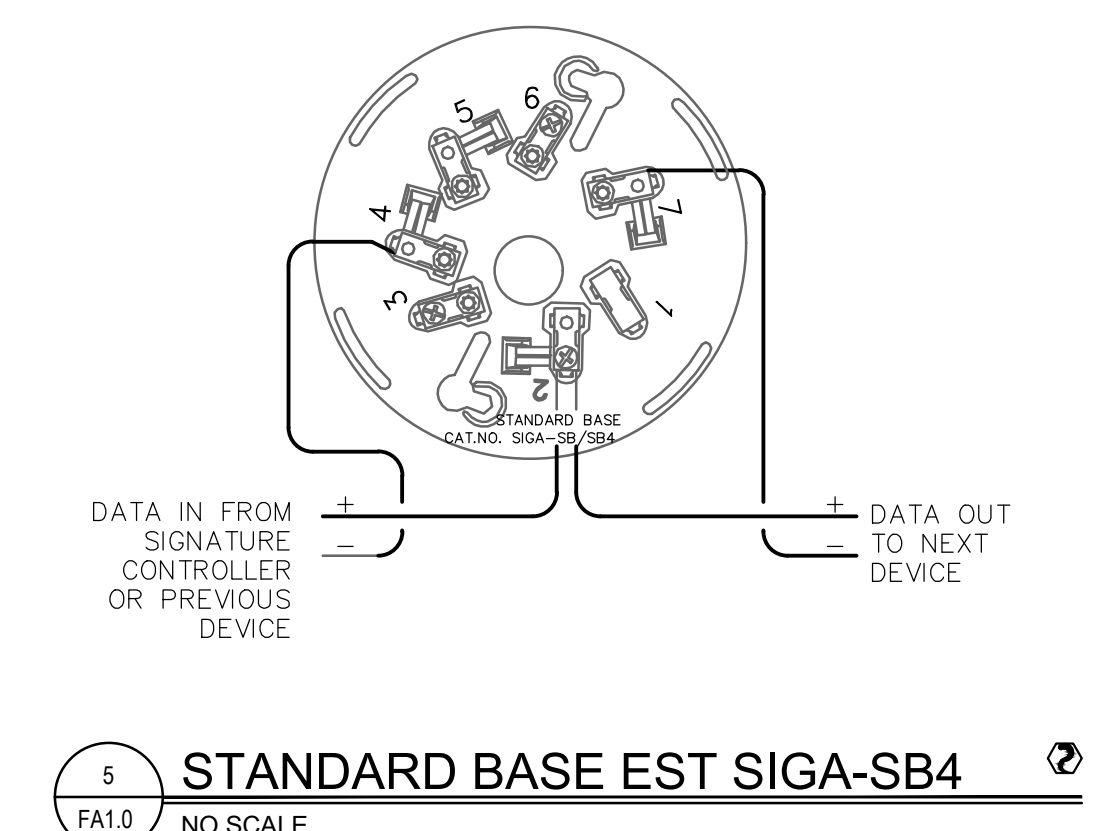


5 STANDARD BASE EST SIGA-SB4
FA1.0 NO SCALE

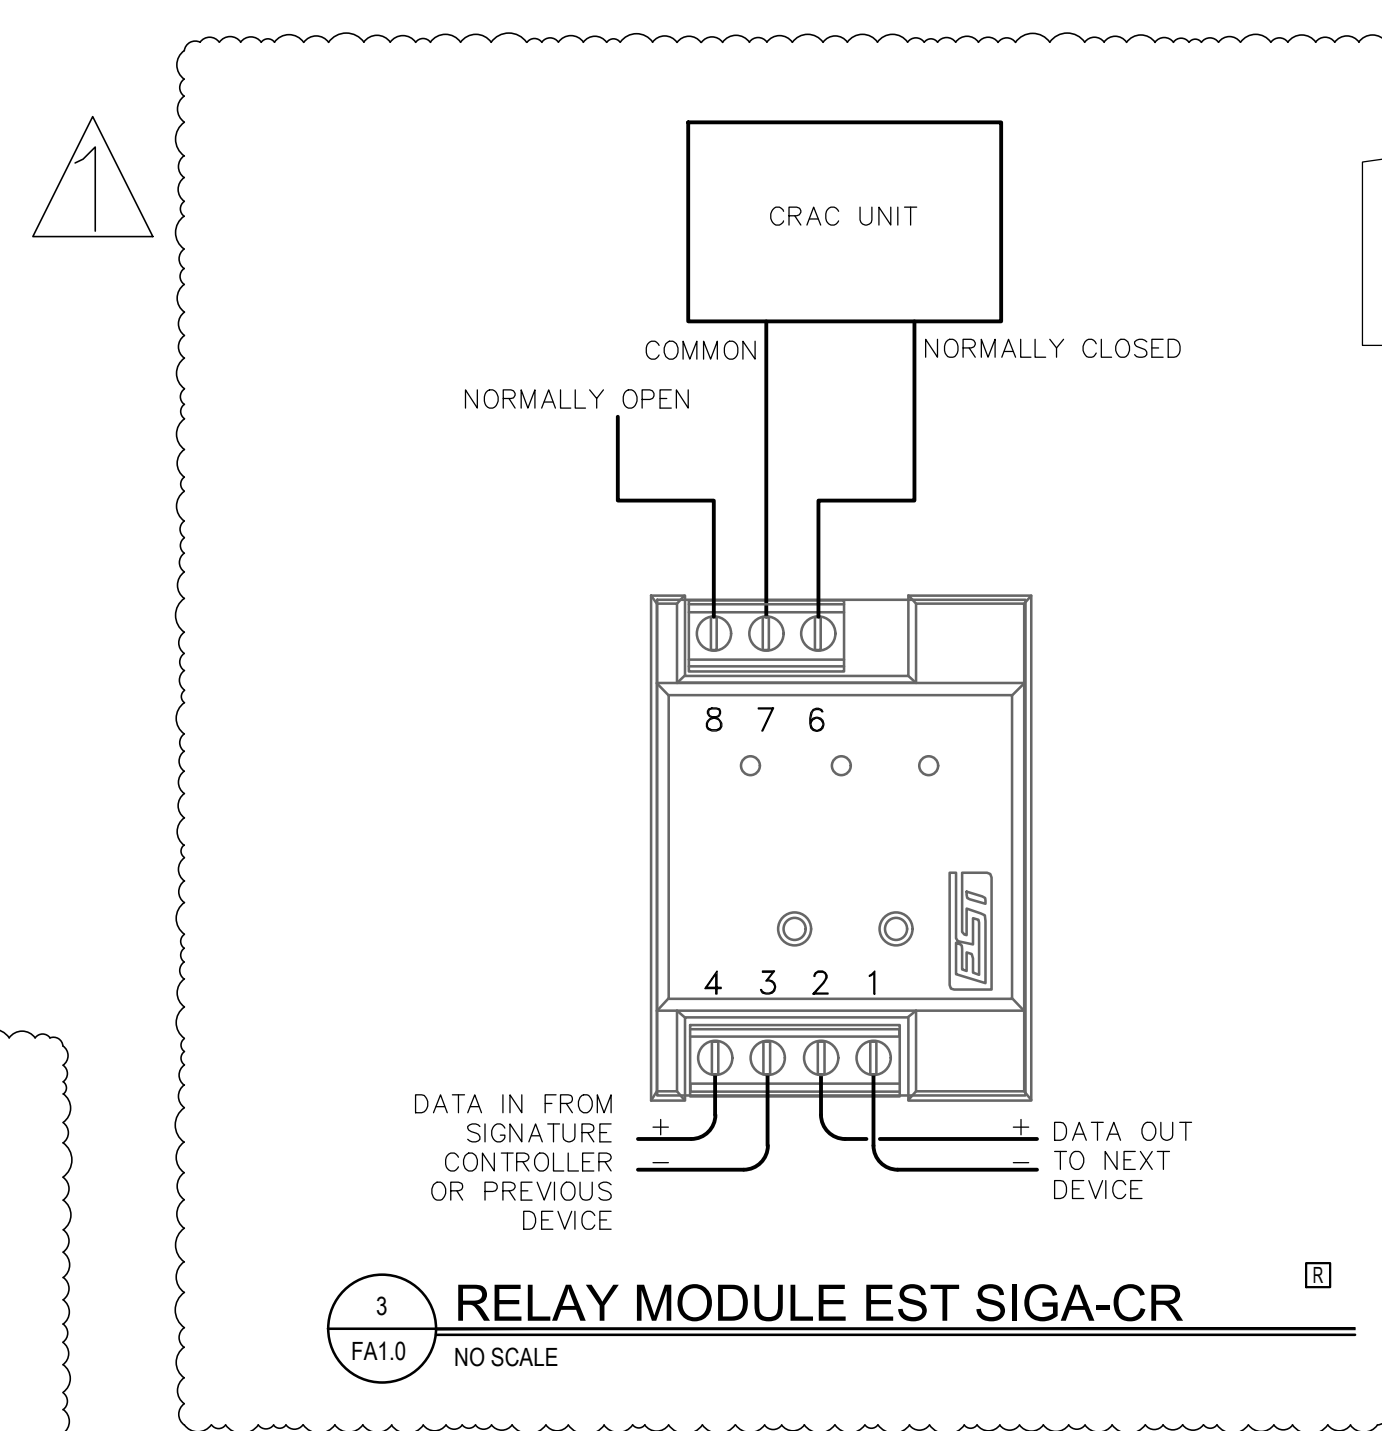

3 RELAY MODULE EST SIGA-CR
FA1.0 NO SCALE

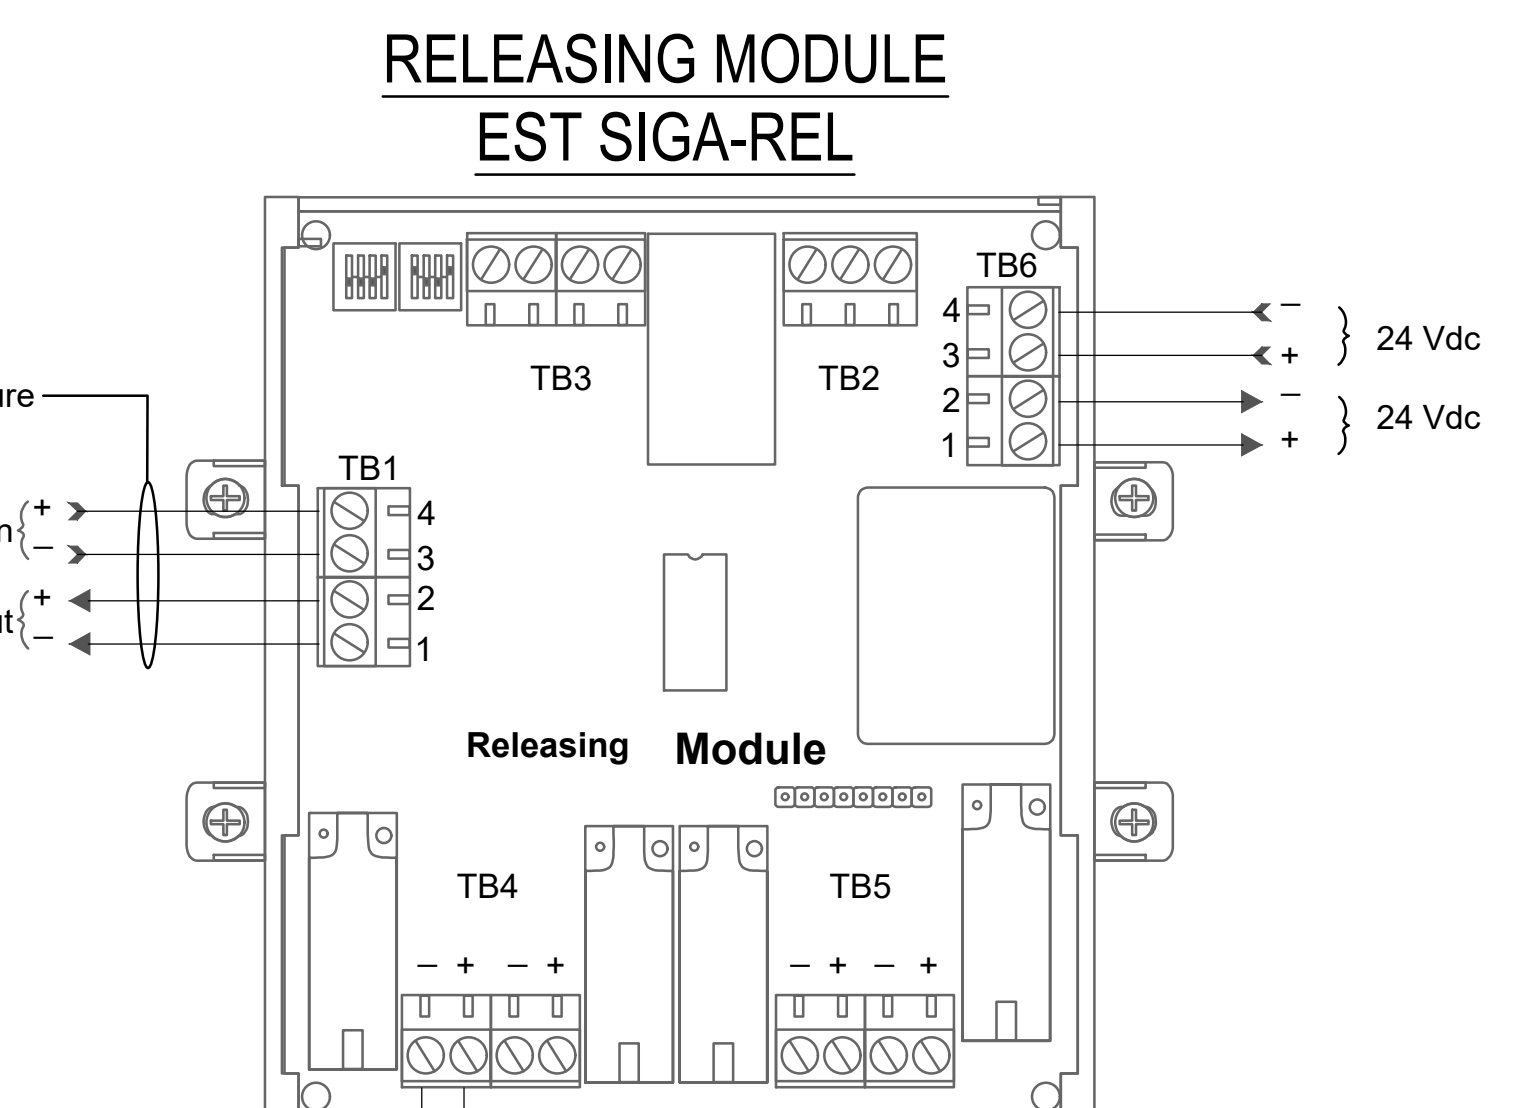

2 RELEASING MODULE EST SIGA-REL
FA1.0 NO SCALE

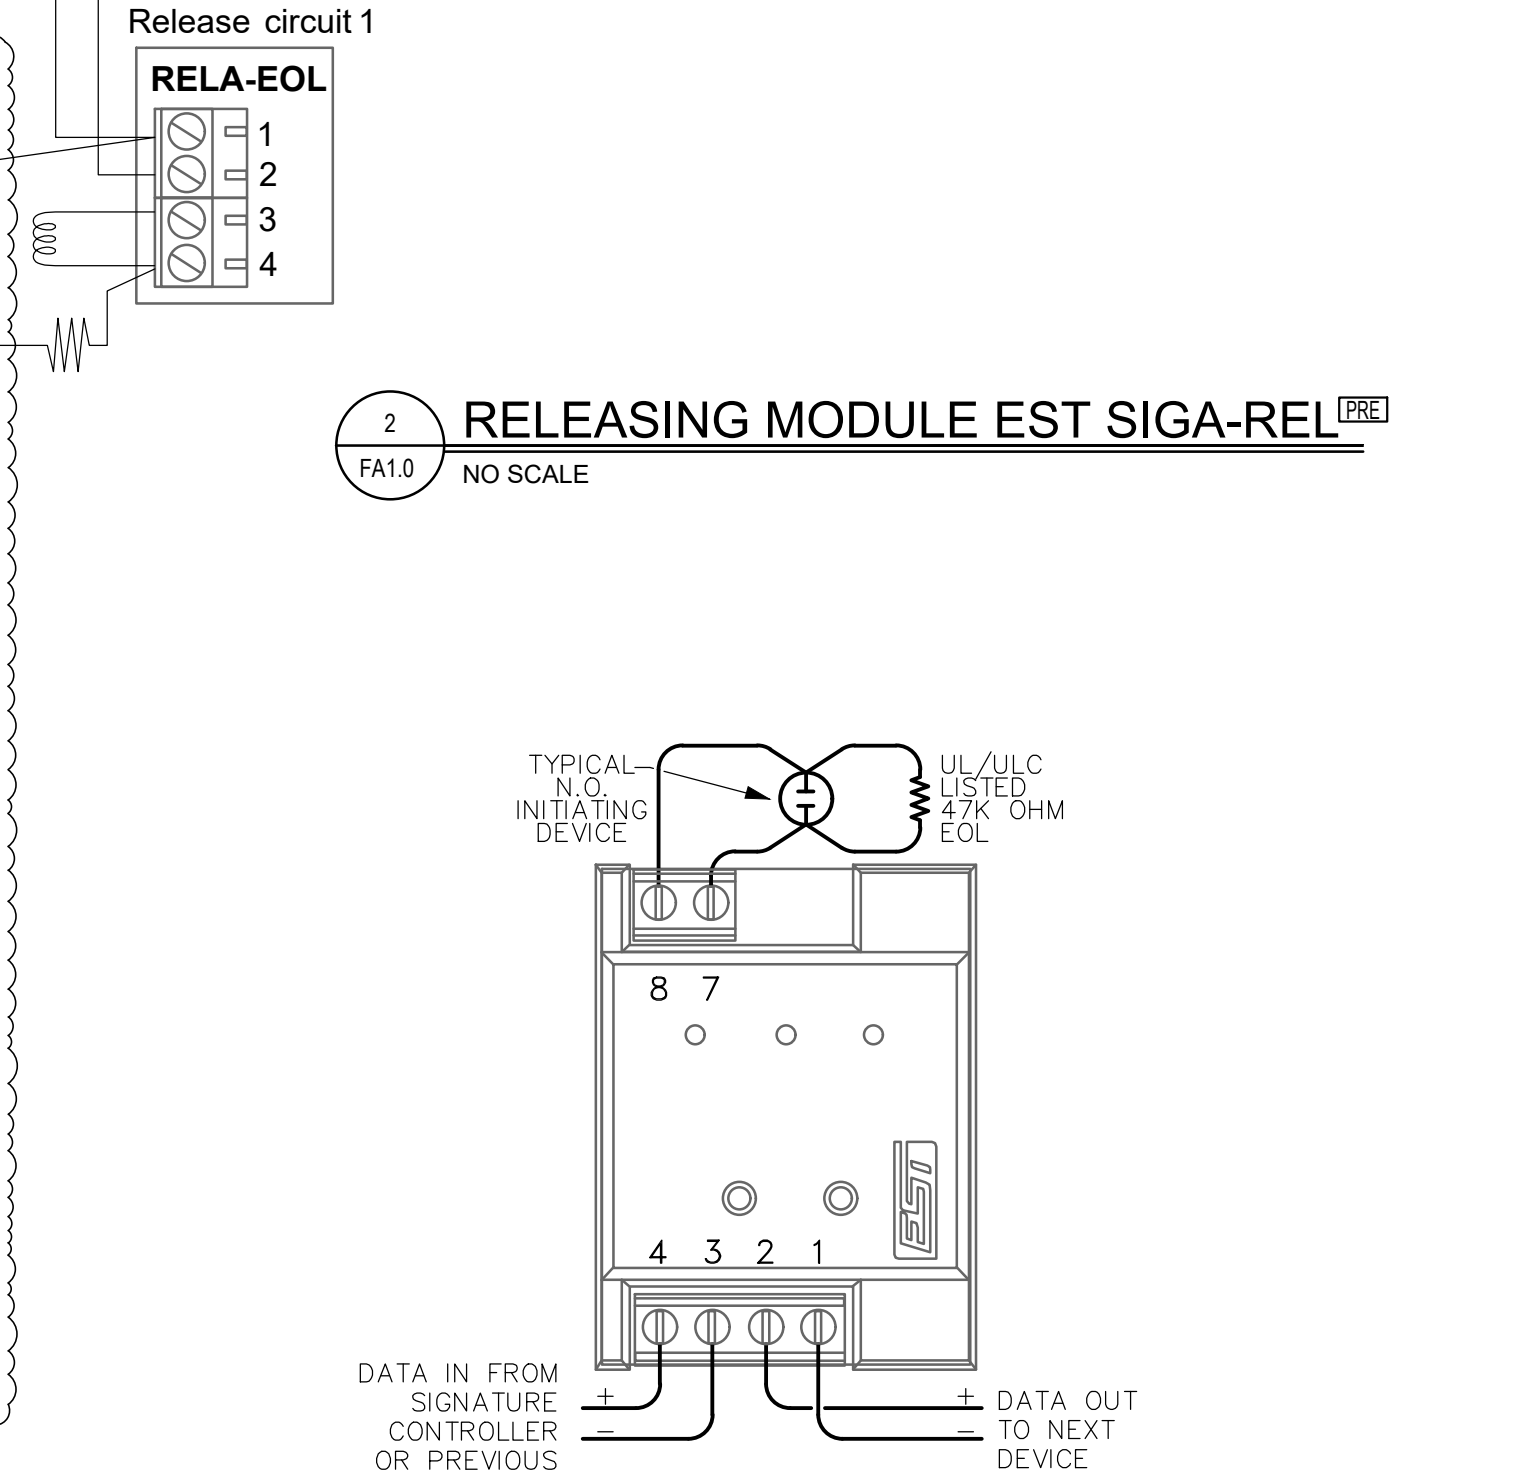


3 INPUT MODULE EST SIGA-CT1
FA1.0 NO SCALE

GENERAL NOTES


1. PLANS CREATED FROM AS-BUILT DRAWINGS AS PROVIDED BY MSU-BOZEMAN
2. DEVICE ADDRESSES TO BE FIELD COORDINATED BASED ON PANEL PROGRAM AVAILABILITY. CONTRACTOR TO PROVIDE REDLINES OF ADDRESSES USED FOR ALL NEW WORK TO BE INCORPORATED IN RECORD DOCUMENTS.
3. 'A' CIRCUIT HORNSTROBES SHALL HAVE NEW ADDRESSES AS NOTED
4. ALL EQUIPMENT WITHIN THE DATA ROOMS SHALL BE ADEQUATELY PROTECTED FROM DUST AND DEBRIS DURING INSTALLATION. DATA CENTER MANAGERS SHALL APPROVE PROTECTION BEFORE INSTALLATION OF DEMOLITION WITHIN THE AREA.


PLAN KEY NOTES

1. LOCATION OF EXISTING EST3X FIRE ALARM CONTROL PANEL. CONTRACTOR TO INSTALL NEW RELEASING MODULE FOR NEW FIRE SPRINKLER PREACTION SYSTEM. SEE SCHEDULE
2. NEW SMOKE DETECTORS FOR ACTUATION OF NEW PREACTION ZONE
3. TIE INTO EXISTING SLC CIRCUIT TO PROVIDE WIRING FOR NEW HEAT DETECTORS
4. RE-USE EXISTING MONITOR MODULES AS SHOWN ON FA DEMO SHEET F00.2
5. CONTRACTOR TO PLACE NEW FIRE ALARM DEVICES DIRECTLY ADJACENT TO EXISTING DEVICES. NOW COVERED WITH BLANKS, AS PER THE DEMO SHEET F00.2

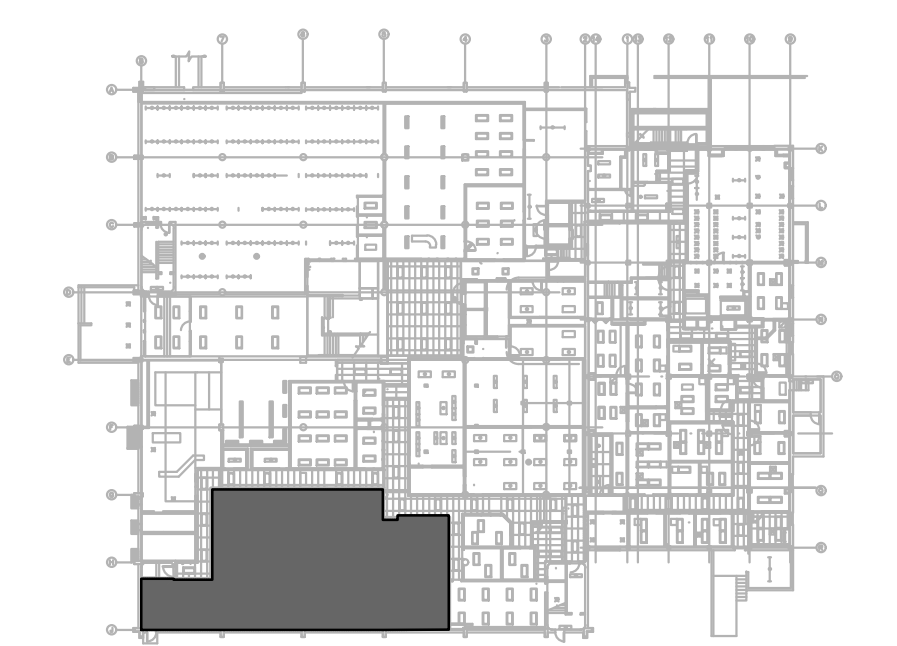


KEYPLAN

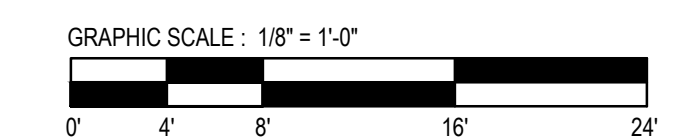

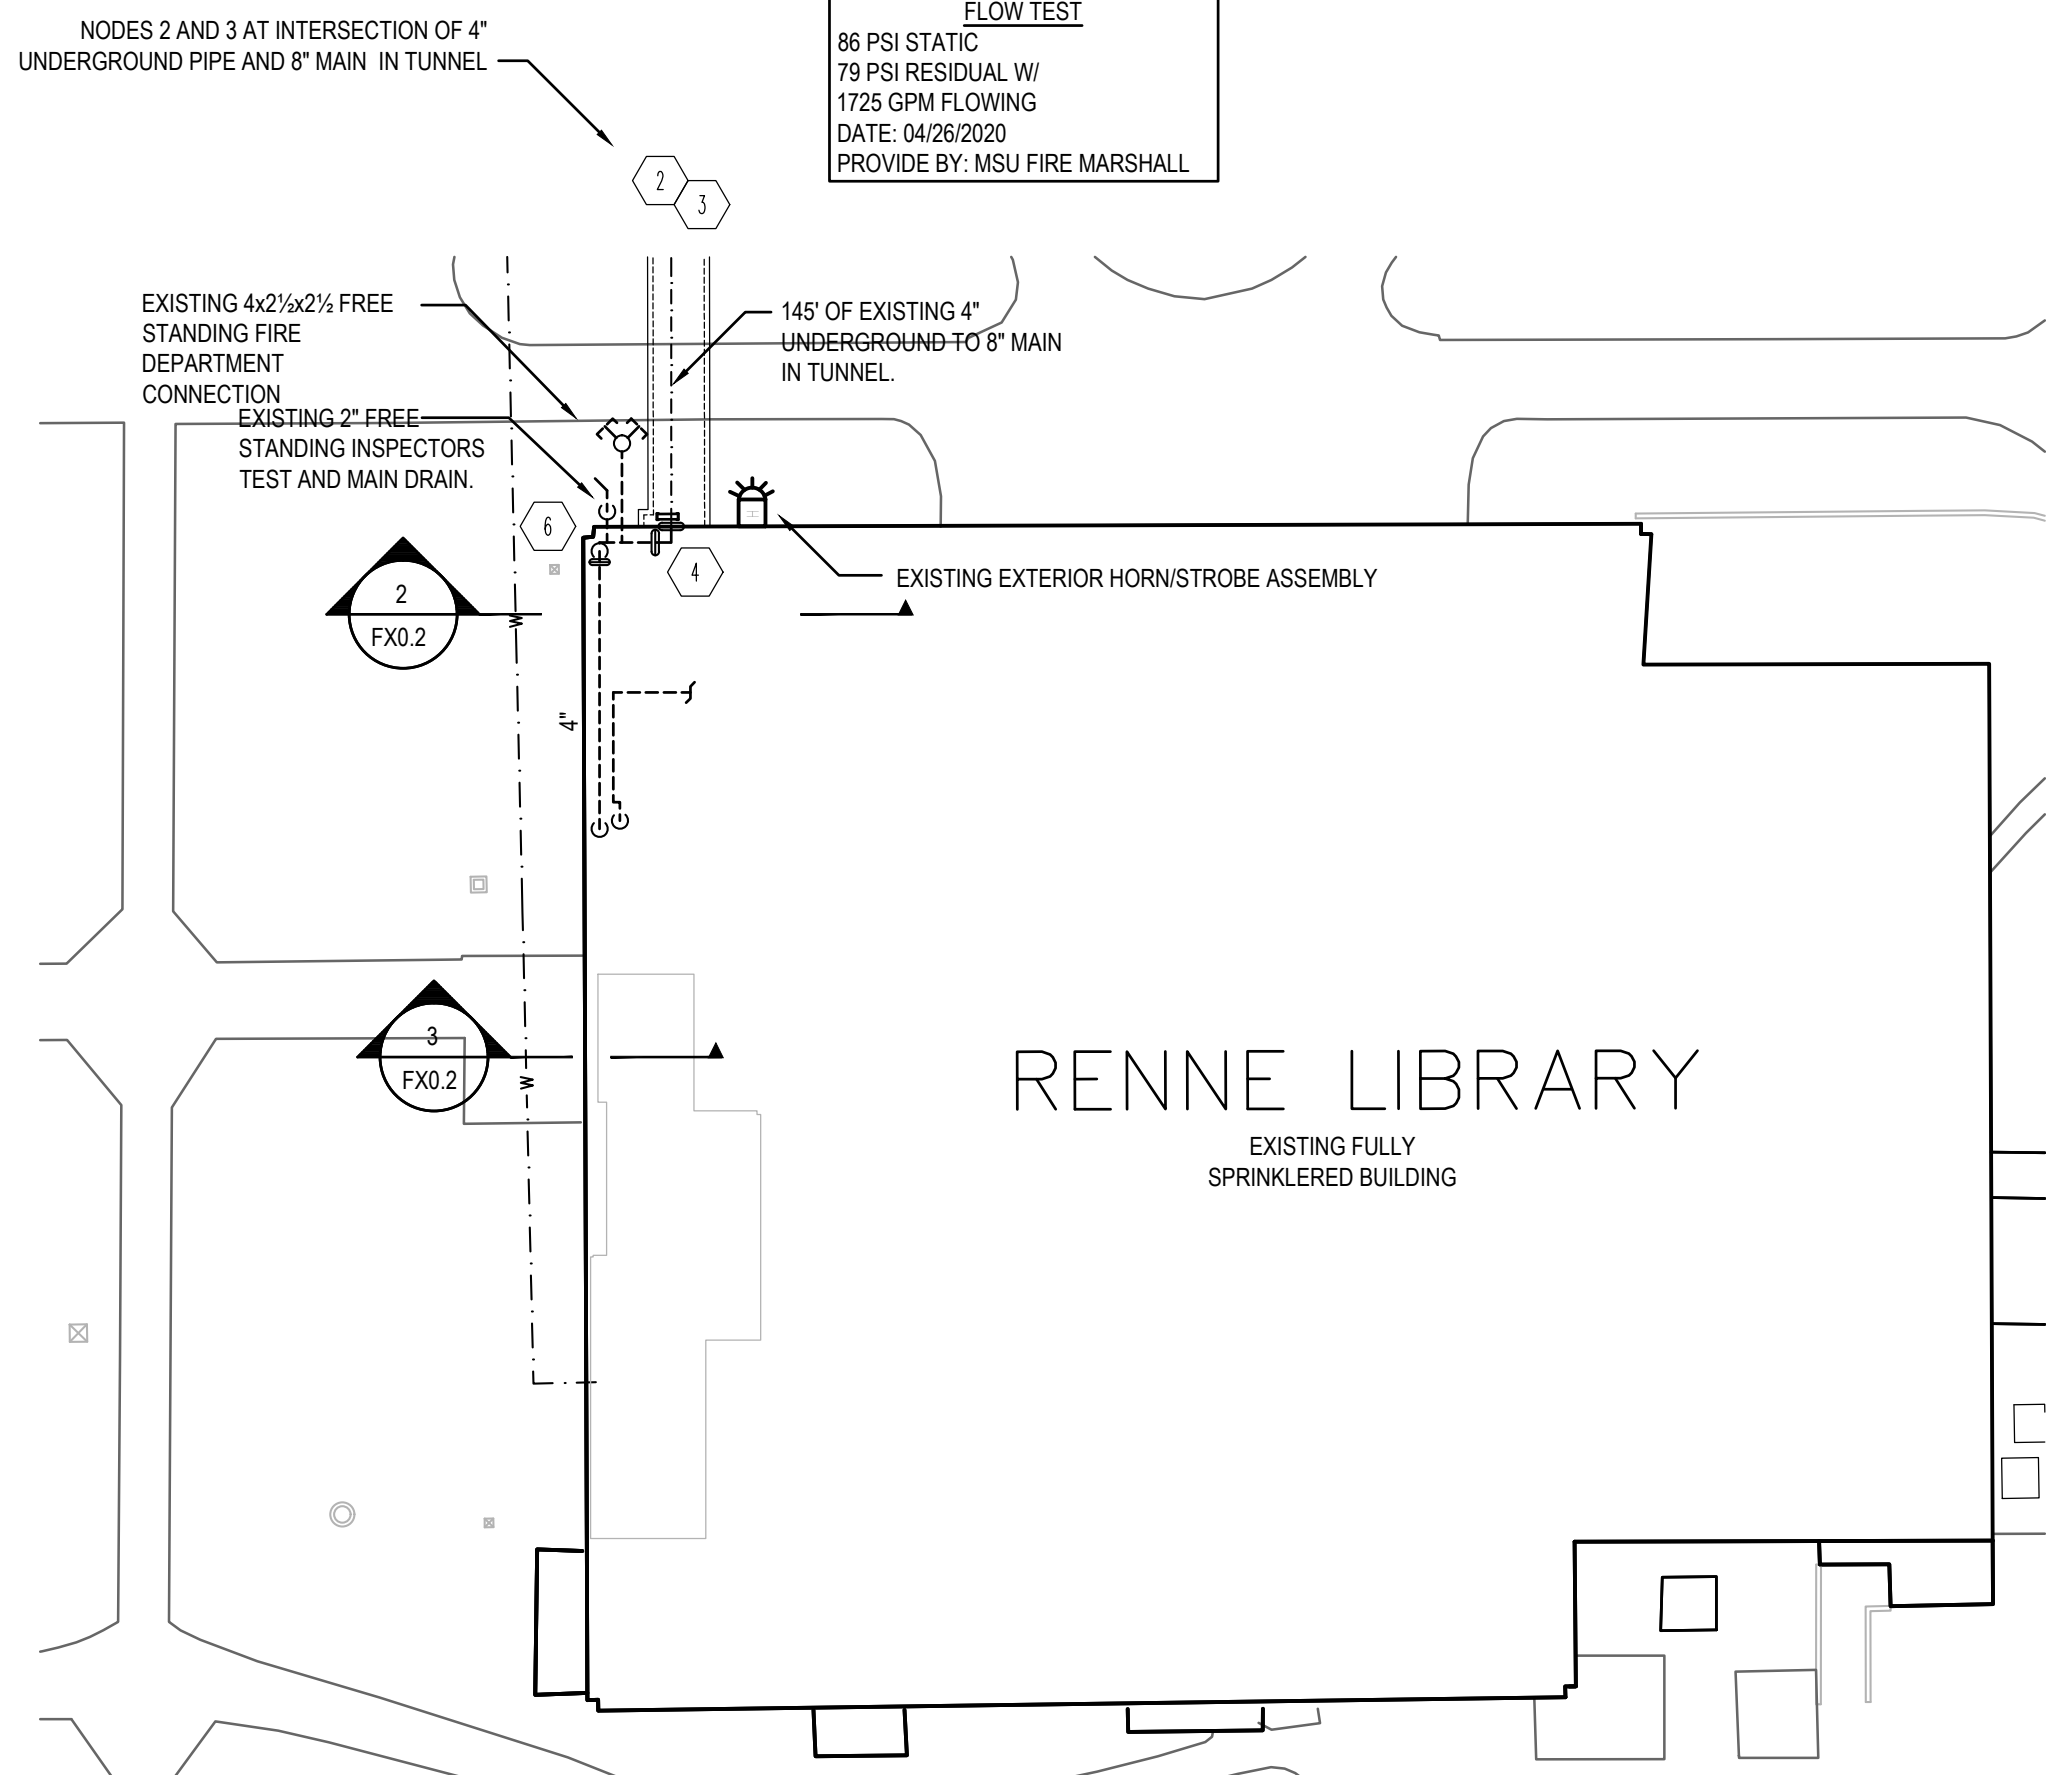


1 FIRE SPRINKLER REFERENCE SITE PLAN
1" = 30'-0"

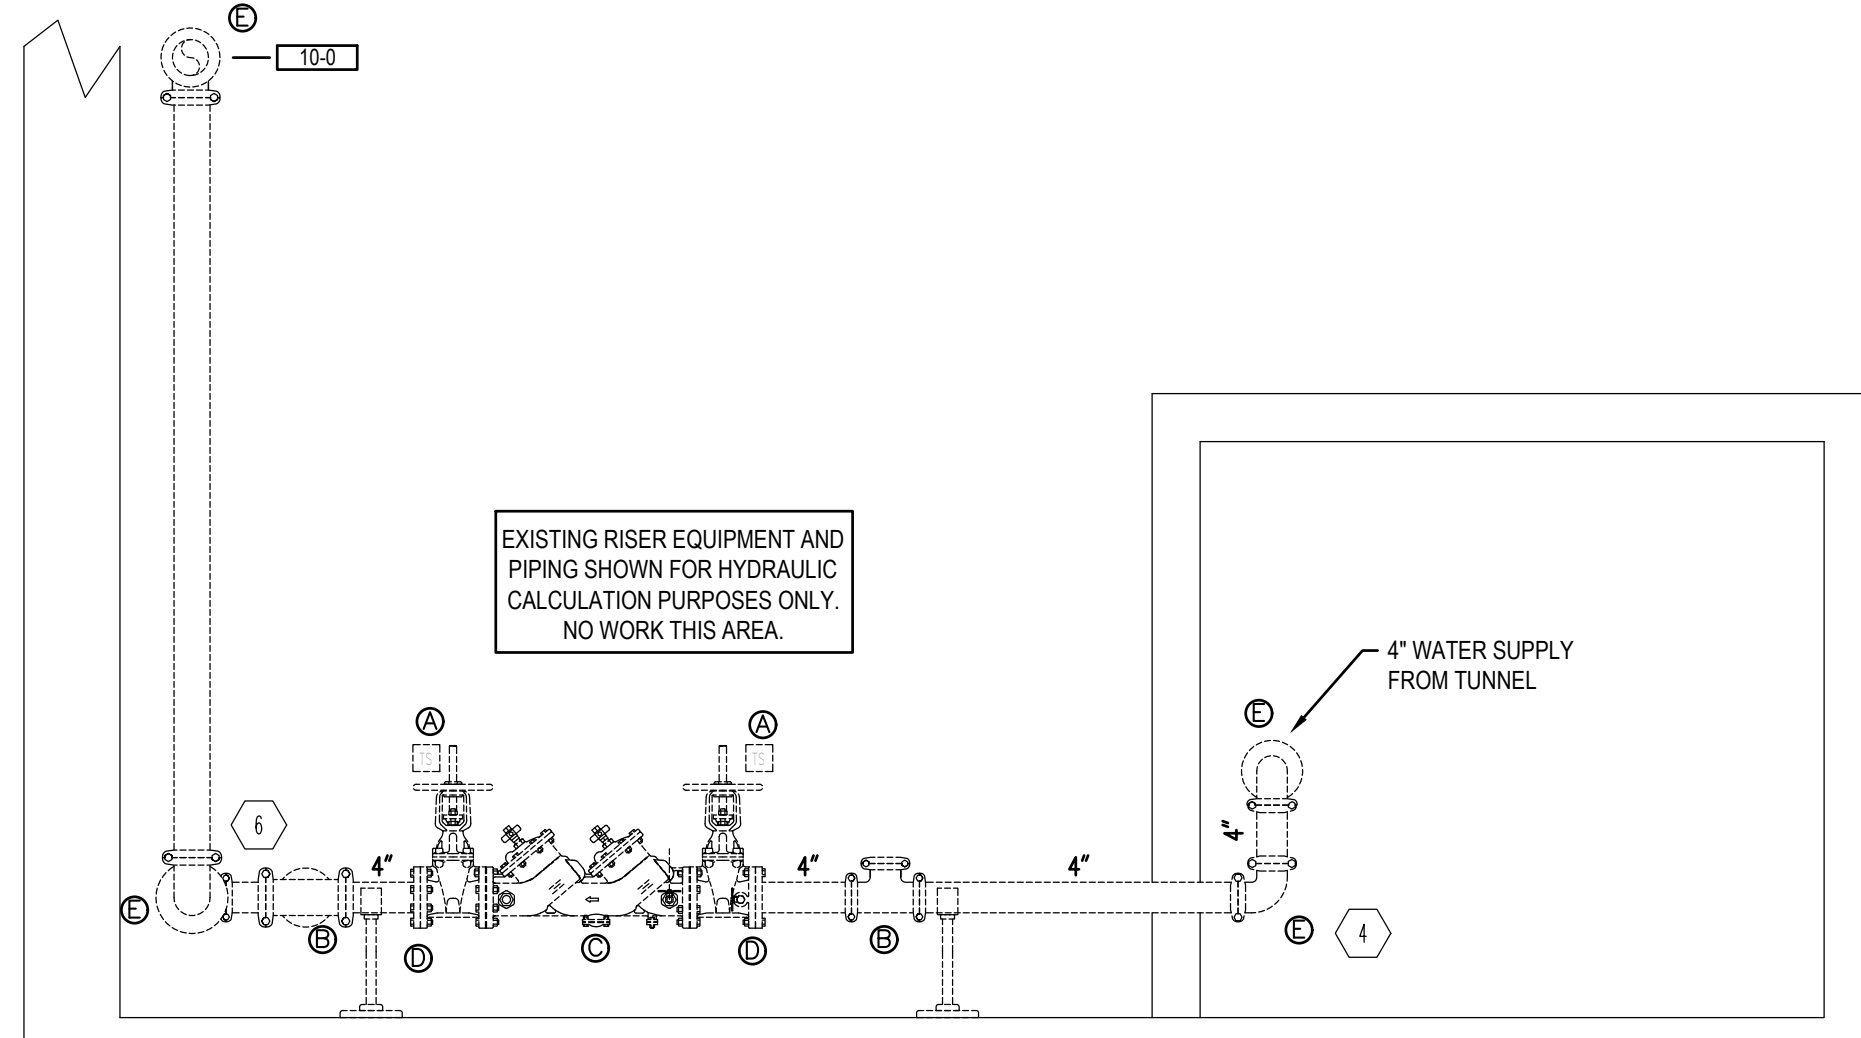

EXISTING RISER LEGEND

- Ⓐ TAMPER SWITCH
- Ⓑ 4" GROOVED TEE
- Ⓒ 4" DOUBLE CHECK VALVE ASSEMBLY
- Ⓓ 4" GROOVED FLANGE
- Ⓔ 4" GROOVED ELBOW
- Ⓕ 4" GROOVED BUTTERFLY VALVE
- Ⓖ 4" RISER ASSEMBLY WITH FLOW SWITCH

2 EXISTING FIRE SPRINKLER RISER DETAIL
1/2" = 1'-0"

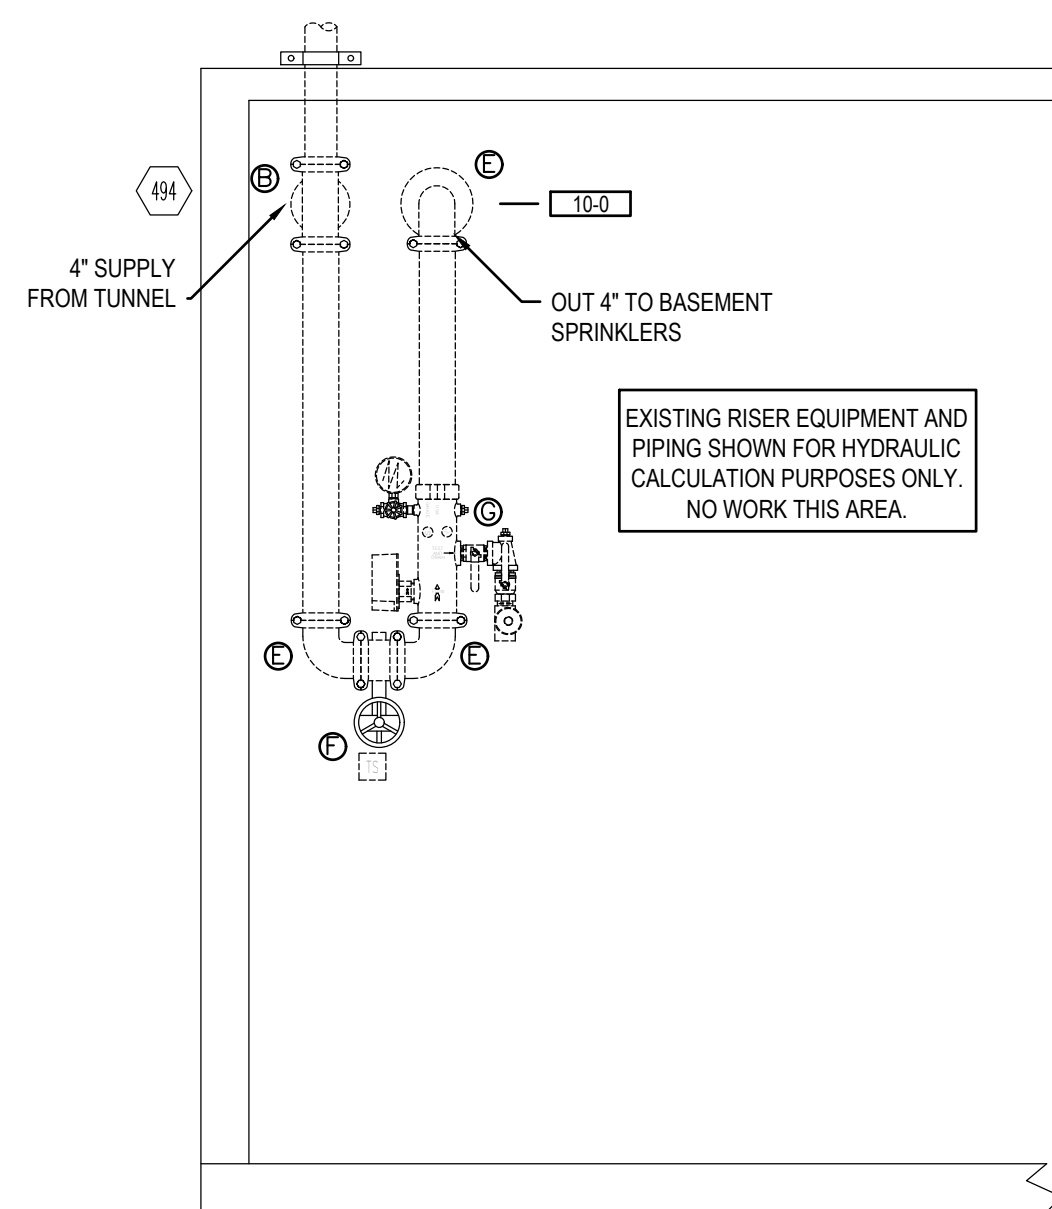


3 EXISTING FIRE SPRINKLER BASEMENT RISER DETAIL
1/2" = 1'-0"

SEISMIC BRACING REQUIREMENTS	
EARTHQUAKE BRACING SHALL CONFORM WITH N.F.P.A. #13 (2016 EDITION), I.B.C. (2018 EDITION), NEHRP, AND ASCE/SEI 7-16 (2016 EDITION) CRITERIA.	
DESCRIPTION OF SITE CONDITIONS	
MAPPED SPECTRAL ACCELERATION FOR SHORT PERIODS	$S_s = 0.683$
MAPPED SPECTRAL ACCELERATION FOR A 1-SECOND PERIOD	$S_1 = 0.215$
SITE CLASS	D
SEISMIC OCCUPANCY CATEGORY OF BUILDING	II
MAXIMUM SPECTRAL RESPONSE ACCELERATION AT SHORT PERIODS	$S_{RS} = 0.571$
MAXIMUM SPECTRAL RESPONSE ACCELERATION AT 1-SECOND PERIODS	$S_{R1} = -$
SEISMIC DESIGN CATEGORY BASED ON S_{RS}	D
SEE CALCULATIONS BELOW FOR DETERMINATION OF FORCE FACTOR FOR SEISMIC DESIGN CATEGORY 'C' & 'D'	
COMPONENT IMPORTANCE FACTOR	$I_p = 1.50$
COMPONENT RESPONSE MODIFICATION FACTOR	$R_p = 4.50$
COMPONENT AMPLIFICATION FACTOR	$A_p = 2.50$
HEIGHT IN STRUCTURE OF POINT OF ATTACHMENT W/ RESPECT TO THE BASE	$Z = 1$
AVERAGE ROOF HEIGHT OF STRUCTURE WITH RESPECT TO THE BASE	$H = 1$
$F_p = 0.4 \cdot A_s \cdot S_{RS} \cdot W_p \cdot (1+2Z)$	$F_p = C_p \cdot W_p$
$F_p = 0.4 \cdot A_s \cdot S_{RS} \cdot W_p \cdot (1+2Z)$	$F_p = 0.571 \cdot W_p$
$F_p = 0.4 \cdot A_s \cdot S_{RS} \cdot W_p \cdot (1+2Z)$	$F_p = 0.407 \cdot W_p$


- FIRE SPRINKLER GENERAL NOTES**
- FIRE PROTECTION SYSTEM SHALL BE DESIGNED, INSTALLED, TESTED, AND FLUSHED IN ACCORDANCE WITH:
 - INTERNATIONAL BUILDING CODE (IBC) - 2018 EDITION WITH LOCALLY ADOPTED MODIFICATIONS
 - NFPA 13 (STANDARD FOR THE INSTALLATION OF SPRINKLER SYSTEMS) - 2016 EDITION
 - NO INSTALLATION OF ANY PIPING OR EQUIPMENT IS TO BEGIN PRIOR TO APPROVAL OF PLANS BY THE AUTHORITY HAVING JURISDICTION AND THE OWNER'S REPRESENTATIVE.
 - ALL PAINTING OF FIRE PROTECTION PIPING AND RELATED COMPONENTS TO BE PERFORMED UNDER THIS CONTRACT AS REQUIRED.
 - ALL ELECTRICAL WIRING OF FIRE ALARM SYSTEM AND FIRE SPRINKLER ELECTRICAL COMPONENTS TO BE PERFORMED BY LICENSED ELECTRICIAN AND SHALL BE SUPERVISED IN ACCORDANCE WITH THE INTERNATIONAL BUILDING CODE AND NFPA 72 (NATIONAL FIRE ALARM CODE).
 - SYSTEM DESIGN ACCOUNTS FOR NO PENETRATIONS IN STRUCTURAL MEMBERS UNLESS OTHERWISE NOTED. OBTAIN APPROVALS FROM THE STRUCTURAL ENGINEER PRIOR TO PENETRATING ANY STRUCTURAL MEMBERS DUE TO FIELD CHANGES.
 - IT IS THE OWNERS RESPONSIBILITY TO PROVIDE ADEQUATE HEAT TO PREVENT FREEZING THROUGHOUT WET PIPE SPRINKLER SYSTEM AREAS AND IN ENCLOSURES FOR DRY PIPE AND OTHER TYPES OF VALVES CONTROLLING WATER SUPPLIES TO SPRINKLER SYSTEMS.

SPRINKLER PIPE AND FITTINGS TABLE		
MATERIALS MAY BE OF DOMESTIC OR IMPORT ORIGIN		
ALL MATERIALS SHALL BE OF "DOMESTIC" OR "DESIGNATED COUNTRY" ORIGIN (FEDERAL PROJECT)		
PIPE SIZE	PIPE	FITTINGS AND OUTLETS
1" TO 2"	GALV SCH-40 DRAIN PIPING	GALVANIZED CLASS-150 MALLEABLE IRON THREADED FITTINGS
1" TO 2"	GALVANIZED SCH-40 PA SYSTEM	BLACK CLASS-125 CAST IRON THREADED FITTINGS (175 PSI RATED)
2 1/2" PREACTION SYSTEM	GALVANIZED SCH-10	WELDED OUTLETS WITH ROLL GROOVED ENDS AND PAINTED DUCTILE IRON GROOVED FITTINGS (300 PSI RATED) (SHORT TAKEOUT I.E. 4" ELL = 4')


BRANCHLINE RESTRAINT REQUIREMENTS	
PER N.F.P.A. #13 2016, CHAPTER 9.3.6	
SEISMIC COEFFICIENT, $C_p = 0.407$	STEEL BRANCH LINE SIZE
SEE SEISMIC CALCULATIONS FOR C_p VALUES	1" 1 1/2" 2"
MAXIMUM SPACING OF BRANCH LINE RESTRAINTS	43' 46' 49' 53'
WHERE NOT REQUIRED: NO RESTRAINT REQUIRED IF HANGER ROD IS LESS THAN 6' LONG MEASURED BETWEEN THE TOP OF THE PIPE AND THE POINT OF ATTACHMENT TO THE BUILDING STRUCTURE.	
WHERE REQUIRED: ON ALL BRANCH LINES (WITH HANGER ROD > 6') AT INTERVALS NOT EXCEEDING THOSE SPECIFIED IN TABLE ABOVE BASED ON BRANCH LINE DIAMETER AND THE VALUE OF C_p . -SPRIG-UPS 4'-0" OR LONGER SHALL BE RESTRAINED AGAINST LATERAL MOVEMENT.	
RESTRAINT SHALL BE PROVIDED BY USE OF ONE OF THE FOLLOWING: 1) A LISTED SWAY BRACE ASSEMBLY 2) A WRAPAROUND U-HOOK 3) #12, 440-LB WIRE INSTALLED AT LEAST 45° FROM THE VERTICAL PLANE AND ANCHORED ON BOTH SIDES OF THE PIPE. 4) A HANGER NOT LESS THAN 45° FROM VERTICAL INSTALLED WITHIN 6" OF THE VERTICAL HANGER ARRANGED FOR RESTRAINT AGAINST UPWARD MOVEMENT, PROVIDED IT IS UTILIZED SUCH THAT LR DOES NOT EXCEED 300, WHERE THE ROD SHALL EXTEND TO THE PIPE OR HAVE A SURGE CLIP RESTRAINT. 5) OTHER APPROVED MEANS	
WIRES USED FOR PIPING RESTRAINTS SHOULD BE ATTACHED TO THE BRANCH LINE WITH TWO TIGHT TURNS AROUND THE PIPE AND FASTENED WITH FOUR TIGHT TURNS WITHIN 1-1/2" (SEE DETAIL), AND ATTACHED TO THE STRUCTURE WITH MEANS APPROVED BY NFPA.	
RESTRAINT SHALL BE LOCATED WITHIN 2 FT OF A HANGER. THE HANGER CLOSEST TO THE RESTRAINT SHALL BE OF A TYPE THAT RESISTS UPWARD MOVEMENT OF A BRANCH LINE SUCH AS A SURGE CLIP.	

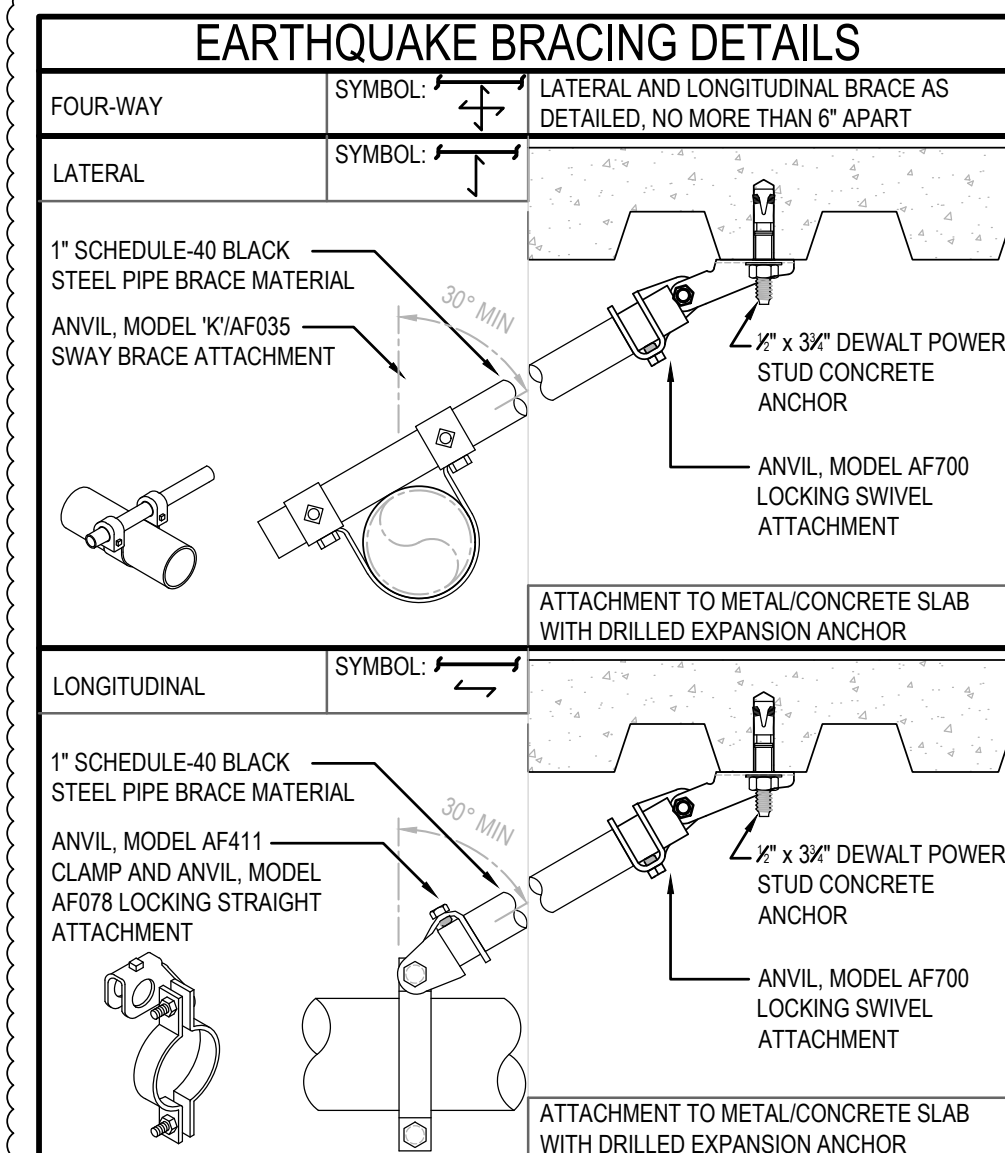

- SEISMIC BRACING NOTES**
- ALL BRACE PIPING SHALL BE SCHEDULE 40 BLACK STEEL.
 - MAX BRACE PIPE LENGTH = 7'-0" (PROVIDE 40° PER BRACE FOR LISTING)
 - MAX LATERAL BRACE SPACING FOR 2 1/2" PIPE = 30'-0" U.O.N.
 - MAX LONGITUDINAL BRACE SPACING FOR 2 1/2" PIPE = 80'-0" U.O.N.

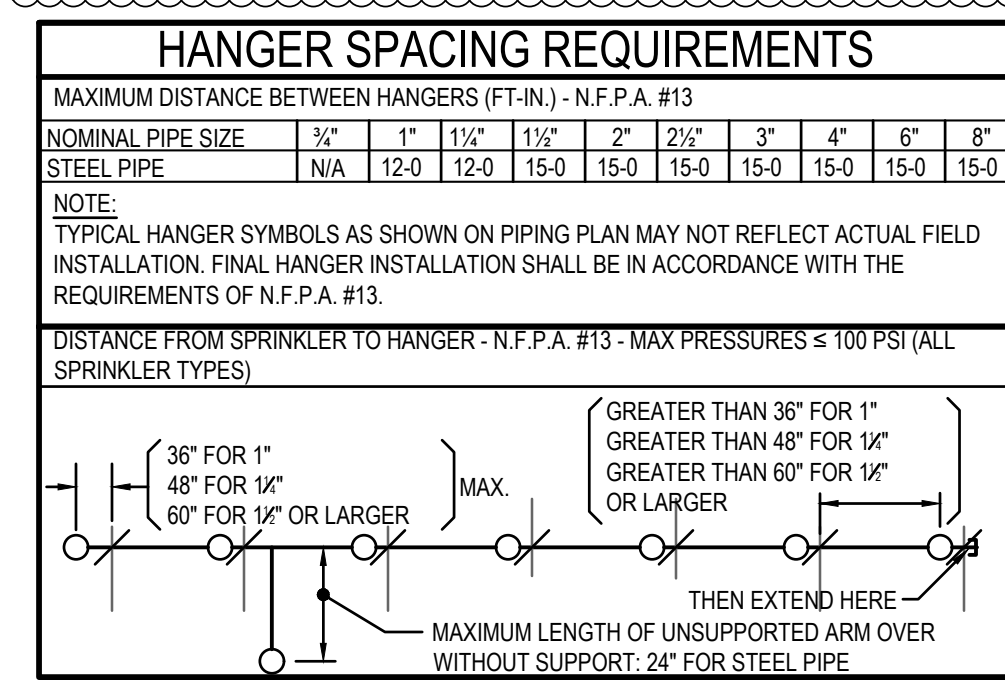

SPRINKLER HEADS - PROJECT TOTAL												
MANUFACTURER	MODEL	TYPE	SIN	FINISH	THREAD	K-FACTOR	CANOPY	ESCUTCH	TEMP	WRENCH	SYMBOL	QUANTITY
TYCO	TY-FRB	PEND	TY323	WHITE	1/2"	5.6	RECD	STY15	200°	W7	⊙	49
TYCO	TYFRB	UP	TY313	BRASS	1/2"	5.6	ON-LINE	N/A	200°	W7	⊙	2
TYCO	TYFRB	UP	TY313	BRASS	1/2"	5.6	SPRIG	N/A	200°	W7	⊙	1
TOTAL											52	

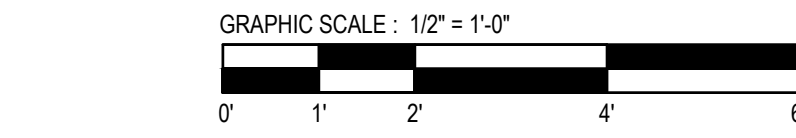

FIRE SPRINKLER LEGEND	
SYMBOL	DESCRIPTION
⊙	STANDARD SPRAY PENDENT SPRINKLER ON - DROP
⊙	STANDARD SPRAY UPRIGHT SPRINKLER ON - LINE
⊙	STANDARD SPRAY UPRIGHT SPRINKLER ON - SPRIG
⊙	EXISTING PENDENT SPRINKLER
⊙	EXISTING UPRIGHT SPRINKLER
⊙	LATERAL OR LONGITUDINAL SWAY BRACE
⊙	COMBINATION LATERAL AND LONGITUDINAL SWAY BRACE
⊙	FLOW SWITCH
⊙	TAMPER SWITCH
⊙	LOW AIR ALARM
⊙	PRESSURE REDUCING VALVE
⊙	PRESSURE SWITCH
⊙	CHECK VALVE
⊙	BUTTERFLY VALVE (GROOVED OR THREADED)
⊙	GLOBE VALVE
⊙	HORNSTROBE ASSEMBLY
⊙	FREE STANDING FIRE DEPARTMENT CONNECTION
⊙	PIPE CENTERLINE FROM FINISHED FLOOR
⊙	HYDRAULIC NODE POINT
⊙	CEILING HEIGHT
⊙	RISER
⊙	DISTANCE PIPE FROM DECK
⊙	GROOVED ELBOW UP
⊙	GROOVED ELBOW DOWN
⊙	FLEXIBLE GROOVED COUPLING
⊙	GROOVED COUPLING
⊙	SCREWED ELBOW DOWN
⊙	SCREWED ELBOW UP
⊙	HANGER SYMBOL - SEE DETAIL FOR TYPE
⊙	HANGER SYMBOL - SEE DETAIL FOR TYPE
⊙	SEISMIC RESTRAINT #1
⊙	SEISMIC RESTRAINT #2
⊙	HEAD BOX
⊙	TAPPING VALVE
⊙	THRUST BLOCKING/PLUG
⊙	NEW PREACTION SPRINKLER PIPE
⊙	EXISTING SPRINKLER PIPE
⊙	DEMO SPRINKLER PIPE
⊙	EXISTING UNDERGROUND WATER MAIN/FIRE MAIN
⊙	ABOVE FINISHED FLOOR
⊙	ALL THREAD ROD
⊙	AUTOMATIC SPRINKLER
⊙	CUT IN FIELD
⊙	DOWN
⊙	FIRE DEPARTMENT CONNECTION
⊙	FINISHED GRADE
⊙	GALVANIZED
⊙	GROOVE BOTH ENDS
⊙	GROOVE ONE END
⊙	GALVANIZED MALLEABLE IRON
⊙	OUTSIDE STEM & YOKE
⊙	PRE-ACTION
⊙	RISER NIPPLE
⊙	THREAD BOTH ENDS
⊙	THREAD ONE END
⊙	THREAD AND GROOVE
⊙	UNLESS OTHERWISE NOTED

SEISMIC CLEARANCE REQUIREMENTS		
PROVIDE CLEARANCE AT ALL PIPING EXTENDING THROUGH WALLS, FLOORS, FOUNDATIONS. NO CLEARANCE REQUIRED AT GYPSUM BOARD OR EQUALLY FRANGIBLE CONSTRUCTION THAT IS NOT REQUIRED TO HAVE A FIRE RESISTANCE RATING.		
NOMINAL PIPE SIZE	CORE DRILL HOLE OR PIPE SLEEVE SIZE	AT CONTRACTORS OPTION FLEXIBLE COUPLINGS MAY BE INSTALLED WITHIN 12" OF THE WALL SURFACE ON EACH SIDE, OR WITHIN 12" ABOVE FLOOR AND 24" BELOW FLOOR, AND THE CLEARANCES NOTED ARE NOT REQUIRED.
INCH	MM	
1	25	3 80
1 1/2	32	4 100
2	50	4 100
2 1/2	65	6 150
3	80	6 150
4	100	8 200
6	150	10 250

MONTANA STATE UNIVERSITY

MSU-CPDC

MONTANA STATE UNIVERSITY
BOZEMAN, MONTANA
PHONE: 406.994.5413
FAX: 406.994.5665

RENNE LIBRARY
DATA CENTER - FIRE PROTECTION UPGRADES

COFFMAN ENGINEERS
713 Columbia Ave., Suite 101
Bozeman, MT 59717
Phone: 406.592.1818
www.coffman.com

DRAWN BY: BMH

REV.	DESCRIPTION	DATE
Δ	ADDENDUM	11.25.21

JASON ANDERSON
No. 11805PE
REGISTERED PROFESSIONAL ENGINEER

PPA#20-0036

SHEET TITLE

F.S. GENERAL NOTES & SITE PLAN

SHEET
FX0.2

DATE
01-17-2021